

# Registration Statement

## OF CLAIMANT OF RIGHT TO APPROPRIATE GROUND WATER

(Under Chapter 708, Oregon Laws 1955.)

TO THE STATE ENGINEER OF OREGON:

I, Jonathan J. Summers

of Rt. 1, Box 575A, Clackamas County of Clackamas

State of Oregon, do hereby make application for a certificate of registration as evidence of a right to appropriate ground water.

1. Source from which water is withdrawn is Pump well  
(Flowing well, pump well, infiltration trench, or tunnel)

2. Location is: 2 miles northeast of Clackamas  
(Approximate distance and direction from nearest city or town)

and is more particularly described as follows:

(a) 355 feet north and 165 feet west of the section corner common to sections 3, 2, 10, and 11  
(Give distance and bearing to corner of section or other legal subdivision)

being within s.e. quarter of s.e. quarter of Sec. 3, Twp. 2 S, Rge. 2 E  
(Smallest legal subdivision) (N. or S.) (E. or W.)

or (b) within limits of recorded platted property, town or city: none

in Lot \_\_\_\_\_, Block \_\_\_\_\_ of \_\_\_\_\_  
(Name of plat or addition)

none County of Clackamas  
(If within city or town, give name)

3. Construction Work was begun on April 1, 1953; was completed on April 24, 1953  
(Date) (Date)

and the ground water claimed was first used for the purposes set out below on May 1953  
(Date)

since which time the water has been used continuously  
(Continuously or intermittently)

from May 1953 to June 1958  
(Date) (Date)

4. Quantity of water claimed and used is 31 gallons per minute; \_\_\_\_\_ acre feet per year.

5. Purpose or Purposes for which water is used irrigation and domestic water

(Domestic, irrigation, municipal, manufacturing, industrial, etc.)

6. Description of Well: Depth 163 feet. Type drilled  
(Dug or drilled)

diameter 8 inches. Elevation of ground at well site 100 feet, mean sea level.  
(As near as known)

Depth to water table 38 feet.

7. Capacity of Well: 31 g.p.m. with 15 feet drawdown.

33 g.p.m. with 110 feet drawdown.

Date of test April 24, 1953

If Flowing Well: Measured discharge none g.p.m. on \_\_\_\_\_  
(Date)

Shut-in pressure at ground surface \_\_\_\_\_ lbs. per sq. in. on \_\_\_\_\_  
(Date)

Water is controlled by \_\_\_\_\_  
(Cap, valve, etc.)

8. Casing: (Give diameter, commercial specifications and depth below ground surface of each casing size.)

8 inch diameter ..... from 0 to 50 feet  
~~none~~ inch diameter ..... from 50 to 165 feet  
inch diameter ..... from ..... to ..... feet  
inch diameter ..... from ..... to ..... feet

Describe and show depth of shoe, plug, adapter, liner or other details: ~~none~~

9. Perforated Casings or Screens:

~~none~~ ..... from ..... to .....  
(Number per foot and size of perforations, or describe screen)  
..... from ..... to .....  
..... from ..... to .....  
..... from ..... to .....

10. Log of Well: (Describe each stratum or formation clearly, indicate if water bearing, and give thickness and depth as indicated.)

MATERIAL	Thickness (Feet)	Depth to Bottom (Feet)
Clay	16	16
Cement gravel	34	50
Solid hard rock	80	130
Softer rock	18	148
Cement gravel	15	163

If log of well is not available, give name and address of driller.

A. L. Zissing, dead

11. Infiltration Trench: Covered or open none

Dimensions: Length \_\_\_\_\_ ft. Minimum depth \_\_\_\_\_ ft. Maximum depth \_\_\_\_\_ ft.

Bottom width \_\_\_\_\_ ff. Discharge \_\_\_\_\_ g.p.m. Date of test \_\_\_\_\_

12. Tunnel: Type of lining none

Dimensions: \_\_\_\_\_  
(Length, course, and cross sectional size)

Position of water bearing stratum with reference to portal of tunnel \_\_\_\_\_

Log of tunnel: (Preceding table for log of well may be used, if desired. Give footage from portal and character of materials, as pertinent.)

13. Pumping Equipment: ?

(a) Pump Jaccuzzi submersible Capacity 34 g.p.m.  
(Make, type and size)

(b) Motor General Electric 5 1/2 HP  
(Type and horsepower)


14. Location of area irrigated or to be irrigated, or place of use if for purposes other than irrigation.

Township North or South	Range E. or W. of Willamette Meridian	Section	Forty-acre Tract	Number Acres To Be Irrigated	Date of Reclamation
28	R 2	3	SE quarter of SEquarter	10	May 1953

15. If the ground water supply is supplemental to an existing water supply, identification of any application for a permit, permit, certificate or adjudicated right to appropriate water made or held by the registrant.

none

Township 28 Range 2E, W.M.  
North

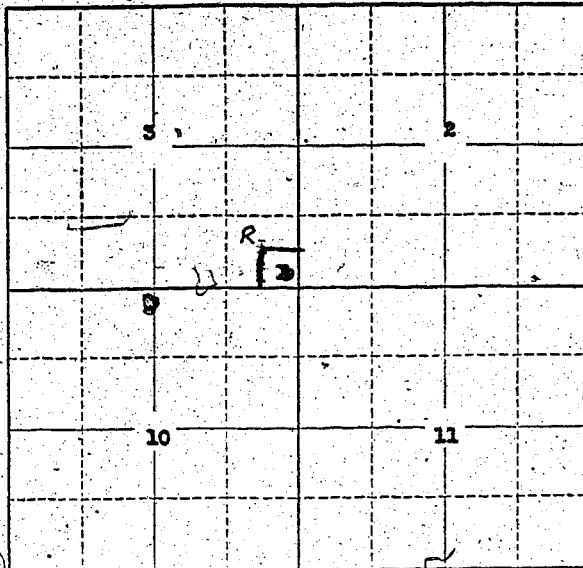

Locate well and acreage of irrigated land on plat.  
Scale: 2" = 1 Mile.

STATE OF OREGON }  
County of Clackamas } ss.

I, Jonathan J. Summers, being first duly sworn, do hereby certify that I have read the foregoing Registration Statement and that all of the items therein contained are true to the best of my knowledge and belief.

*Jonathan J. Summers*  
(Signature of Registrant)

Subscribed and sworn to before me this 26th day of June, 1958

My commission expires \_\_\_\_\_

*George A. [unclear]*  
(Notary Public)  
My Commission Expires Aug. 19, 1960

(SEAL)

**CERTIFICATE OF REGISTRATION**

STATE OF OREGON }  
County of Marion } ss.

This is to certify that the foregoing Registration Statement was received in the office of the State Engineer on the 27th day of June, 1958, at 8:00 o'clock A. M. and has been duly recorded in said office in Book No. 8 of Registration Statements on page GR-1832

~~xxxxxx~~  
~~xxxxxx~~

Witness my hand this 26th day of January, 1959

*Lewis A. [unclear]*  
(State Engineer)

\$15.00

By \_\_\_\_\_  
(Deputy)

GR-1832