

# Registration Statement

## OF CLAIMANT OF RIGHT TO APPROPRIATE GROUND WATER

(Under Chapter 768, Oregon Laws 1955.)

# 2

TO THE STATE ENGINEER OF OREGON:

I, James E. Detering  
of Rt 2 Box 448, Eugene, County of Lane

State of Oregon, do hereby make application for a certificate of registration as evidence of a right to appropriate ground water.

1. Source from which water is withdrawn is pump well #1  
(Flowing well, pump well, infiltration trench, or tunnel)

2. Location is: 3 miles N W of Coburg, Oregon  
(Approximate distance and direction from nearest city or town)

and is more particularly described as follows:

(a) ~~SW 1/4 THE SE 1/4~~ 450' N. and 1665' W. of the S E corner  
(Give distance and bearing to corner of section or other legal subdivision)  
being within SW 1/4 THE SE 1/4 of Sec. 11, Twp. 16 S, Rge. 4 W  
(Smallest legal subdivision) (N. or S.) (E. or W.)

or (b) within limits of recorded platted property, town or city:

in Lot \_\_\_\_\_, Block \_\_\_\_\_ of \_\_\_\_\_  
(Name of plat or addition)

County of \_\_\_\_\_  
(If within city or town, give name)

3. Construction Work was begun on April 1945, was completed on April 1945  
(Date) (Date)

and the ground water claimed was first used for the purposes set out below on May 1945  
(Date)

since which time the water has been used continuously  
(Continuously or intermittently)

from May 1945 to 1958  
(Date) (Date)

4. Quantity of water claimed and used is 350 gallons per minute; 30 acre feet per year.

5. Purpose or Purposes for which water is used irrigation

(Domestic, irrigation, municipal, manufacturing, industrial, etc.)

6. Description of Well: Depth 22 feet. Type driven  
(Dug or drilled)

diameter two (2) 4" pipes inches. Elevation of ground at well site 351 feet, mean sea level.  
(As near as known)

Depth to water table 8' feet. (Estimate)

7. Capacity of Well: \_\_\_\_\_ g.p.m. with \_\_\_\_\_ feet drawdown.

\_\_\_\_\_ g.p.m. with \_\_\_\_\_ feet drawdown.

Date of test not tested

If Flowing Well: Measured discharge not g.p.m. on \_\_\_\_\_  
(Date)

Shut-in pressure at ground surface \_\_\_\_\_ lbs. per sq. in. on \_\_\_\_\_  
(Date)

Water is controlled by \_\_\_\_\_  
(Cap, valve, etc.)



If log of well is not available, give name and address of driller. ....

Driven well no log available

11. Infiltration Trench: Covered or open none .....

Dimensions: Length ..... ft. Minimum depth ..... ft. Maximum depth' ..... ft.

Bottom width ..... ft. Discharge ..... g.p.m. Date of test .....

12. Tunnel: Type of lining ..... none .....

Dimensions: .....  
(Length, course, and cross sectional size)

Position of water bearing stratum with reference to portal of tunnel .....

Log of tunnel: (Preceding table for log of well may be used, if desired. Give footage from portal and character of materials, as pertinent.)

13. Pumping Equipment:

(a) Pump ..... Berkeley centrifugal 2 1/2 X 2 ..... 350 at 160 ft of head Capacity ..... g.p.m.  
(Make, type and size)

(b) Motor ..... 15 hp electric .....  
(Type and horsepower)


14. Location of area irrigated or to be irrigated, or place of use if for purposes other than irrigation.

Township North or South	Range E. or W. of Willamette Meridian	Section	Forty-acre Tract	Number Acres To Be Irrigated	Date of Reclamation
16 S	4 W.	11	SW 1/4 the SE 1/4	9.0	before 1950
16 S	4 W.	14	NW 1/4 the NE 1/4	1.0 <u>10.0</u>	before 1950

15. If the ground water supply is supplemental to an existing water supply, identification of any application for a permit, permit, certificate or adjudicated right to appropriate water made or held by the registrant.

not

Township 16.5 Range 4 W, W.M.  
North

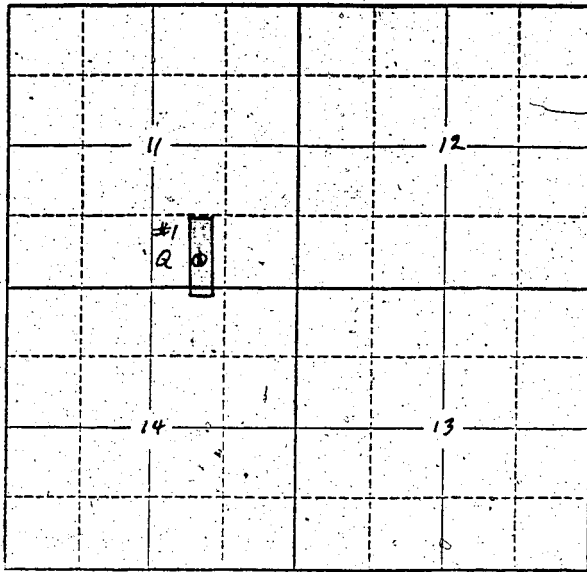

Locate well and acreage of irrigated land on plat.  
Scale: 2" = 1 Mile

STATE OF OREGON }  
County of Linn } ss.

I, James E. Detering, being first duly sworn, do hereby certify that I have read the foregoing Registration Statement and that all of the items therein contained are true to the best of my knowledge and belief.

*James E. Detering*  
(Signature of Registrant)

Subscribed and sworn to before me this 14th day of March, 1958.

My commission expires August 13, 1958.

*Wm. W. ...*  
Notary Public for Oregon

(SEAL)

**CERTIFICATE OF REGISTRATION**

STATE OF OREGON }  
County of Marion } ss.

This is to certify that the foregoing Registration Statement was received in the office of the State Engineer on the 27th day of June, 1958, at 8:00 o'clock A.M. and has been duly recorded in said office in Book No. 8 of Registration Statements on page GR-1770

~~Construction shall be completed by 10 and the water completely applied to beneficial use by 10~~

Witness my hand this 7th day of January, 1959.

*Luva A. ...*  
(State Engineer)

\$15.00

By \_\_\_\_\_ (Deputy)

GR-1770