

Registration Statement

OF CLAIMANT OF RIGHT TO APPROPRIATE GROUND WATER

#2

(Under Chapter 708, Oregon Laws 1955.)

TO THE STATE ENGINEER OF OREGON:

I, James E. Detering

of Rt 2 Box 448, Eugene County of Lane

State of Oregon, do hereby make application for a certificate of registration as evidence of a right to appropriate ground water.

1. Source from which water is withdrawn is pump well #2
(Flowing well, pump well, infiltration trench, or tunnel)

2. Location is: 3 miles S. W. of Coburg, Oregon
(Approximate distance and direction from nearest city or town)

and is more particularly described as follows:

(a) ~~SECTION~~ 650' S.; 750' W. of the NE corner
(Give distance and bearing to corner of section or other legal subdivision)

being within NE 1/4 the NE 1/4 of Sec. 14, Twp. 16S, Rge. 4W
(Smallest legal subdivision) (N. or S.) (E. or W.)

or (b) within limits of recorded platted property, town or city:

in Lot _____, Block _____ of _____
(Name of plat or addition)

County of _____
(If within city or town, give name)

3. Construction Work was begun on 1929; was completed on 1929
(Date) (Date)

and the ground water claimed was first used for the purposes set out below on 1929
(Date)

since which time the water has been used continuously
(Continuously or intermittently)

from 1929 to 1958
(Date) (Date)

4. Quantity of water claimed and used is 350 gallons per minute; 90 acre feet per year.

5. Purpose or Purposes for which water is used Irrigation

(Domestic, irrigation, municipal, manufacturing, industrial, etc.)

6. Description of Well: Depth 19 feet. Type driven
(Dug or drilled)

diameter 5 inches. Elevation of ground at well site 351 feet, mean sea level.
(As near as known)

Depth to water table 12 feet. (estimation)

7. Capacity of Well: _____ g.p.m. with _____ feet drawdown.

_____ g.p.m. with _____ feet drawdown.


Date of test not tested

If Flowing Well: Measured discharge not g.p.m. on _____
(Date)

Shut-in pressure at ground surface _____ lbs. per sq. in. on _____
(Date)

Water is controlled by _____
(Cap, valve, etc.)

Township 16 S Range R4W, W.M.
North.

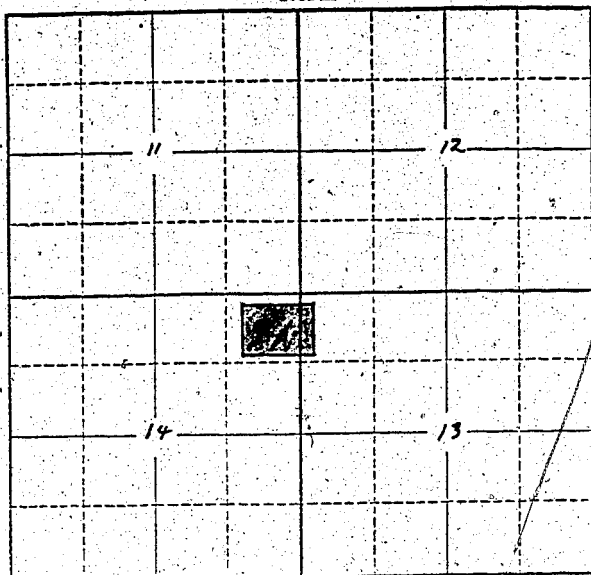

Locate well and acreage of irrigated land on plat.
Scale: 2" = 1 Mile

STATE OF OREGON

County of Lane } ss.

I, James E. Detering, being first duly sworn, do hereby certify that I have read the foregoing Registration Statement and that all of the items therein contained are true to the best of my knowledge and belief.

James E. Detering
(Signature of Registrant)

Subscribed and sworn to before me this 14th day of March, 19 58.

My commission expires August 13, 1958

Wm. L. Deede
Notary Public for Oregon

(SEAL)

CERTIFICATE OF REGISTRATION

STATE OF OREGON

County of Marion } ss.

This is to certify that the foregoing Registration Statement was received in the office of the State Engineer on the 27th day of June, 19 58, at 8:00 o'clock A.M. and has been duly recorded in said office in Book No. 8 of Registration Statements on page GR-1771

~~Construction shall be completed by 1958 and the water completely applied to beneficial use by 1958~~

Witness my hand this 7th day of January, 19 59

Alura A. Stanley
(State Engineer)

By _____ (Deputy)

GR-1771

\$15.00