

Registration Statement

OF CLAIMANT OF RIGHT TO APPROPRIATE GROUND WATER

TO THE STATE ENGINEER OF OREGON:

I, Henry C. Gillock (Minnie R. Gillock), husband and wife
of Williams, Oregon County of Josephine
(Mailing address)

State of Oregon, do hereby make application for a certificate of registration as evidence of a right to appropriate ground water.

1. Source from which water is withdrawn is sump wells
(Flowing well, pump-well, infiltration trench, or tunnel)

2. Location is: One-half mile North of Williams post office
(Approximate distance and direction from nearest city or town)

and is more particularly described as follows:

(a) 825 feet east 500 feet south from NW corner Section 35
(Give distance and bearing to corner of section or other legal subdivision)

being within NW 1/4 of the NW 1/4 of Sec. 35, Twp. T 38, Rge. 5 W
(Smallest legal subdivision) (N. or S.) (E. or W.)

or (b) within limits of recorded platted property, town or city:

in Lot _____, Block _____ of _____
(Name of plat or addition)

County of _____
(If within city or town, give name)

3. Construction Work was begun on 1949; was completed on 1949
(Date) (Date)

and the ground water claimed was first used for the purposes set out below on May, 1949
(Date)

since which time the water has been used Continuously
(Continuously or intermittently)

from May to September
(Date) (Date)

4. Quantity of water claimed and used is 90 gallons per minute; 20 acre
~~XXX~~ per year.

5. Purpose or Purposes for which water is used general irrigation
(Domestic, irrigation, municipal, manufacturing, industrial, etc.)

6. Description of Well: Depth 17' 2" feet; Type dug
(Dug or drilled)

diameter 13 1/2 x 28 1/2 inches; Elevation of ground at well site 1370 feet, mean sea level.
(As near as known)

Depth to water table 5' 9" feet.

7. Capacity of Well: 90 g.p.m. with 4 feet drawdown in 8 hours 6/2/58

90 g.p.m. with 4 feet drawdown in 4 hours 8/1/57

Date of test 8/1/57 and 6/2/58

If Flowing Well: Measured discharge ~~XXX~~ g.p.m. on _____
(Date)

Shut-in pressure at ground surface _____ lbs. per sq. in. on _____
(Date)

Water is controlled by _____
(Cap, valve, etc.)

8. Casing: (Give diameter, commercial specifications and depth below ground surface of each casing size.)

..... inch diameter from to feet
 inch diameter from to feet
 inch diameter from to feet
 inch diameter from to feet

Describe and show depth of shoe, plug, adapter, liner or other details:

9. Perforated Casings or Screens:

(Number per foot and size of perforations, or describe screen) from to
 from to
 from to
 from to

10. Log of Well: (Describe each stratum or formation clearly, indicate if water bearing, and give thickness and depth as indicated.)

| MATERIAL | Thickness (Feet) | Depth to Bottom (Feet) |
|----------|------------------|------------------------|
| | | |
| | | |
If log of well is not available, give name and address of driller.

11. Infiltration Trench: Covered or open

Dimensions: Length ft. Minimum depth ft. Maximum depth ft.

Bottom width ft. Discharge g.p.m. Date of test

12. Tunnel: Type of lining

Dimensions:
(Length, course, and cross sectional size)

Position of water bearing stratum with reference to portal of tunnel

Log of tunnel: (Preceding table for log of well may be used, if desired. Give footage from portal and character of materials, as pertinent.)

13. Pumping Equipment: #1 Sump pump

(a) Pump Berkley 5 horsepower electric Capacity 90 g.p.m.
(Make, type and size)

(b) Motor Electric pressure type
(Type and horsepower)


14. Location of area irrigated or to be irrigated, or place of use if for purposes other than irrigation.

| Township North or South | Range E. or W. of Williamsite Meridian | Section | Forty-acre Tract | Number Acres To Be Irrigated | Date of Reclamation |
|-----------------------------|---|---------|------------------|---------------------------------|------------------------|
| NW 1/4 of NW 1/4 | 5W | 35 | 40 acres | 35 A. | 6/19/58 |
| T38S | R5W | 35 | NW 1/4 of NW 1/4 | 20 ⁺ A. | " |
| | | | | | |
| | | | | | |
15. If the ground water supply is supplemental to an existing water supply, identification of any application for a permit, permit, certificate or adjudicated right to appropriate water made or held by the registrant.

LOCATION FROM
STATE PLAT KEY
391
9/6

Township 38 S Range 5W W.M.
North

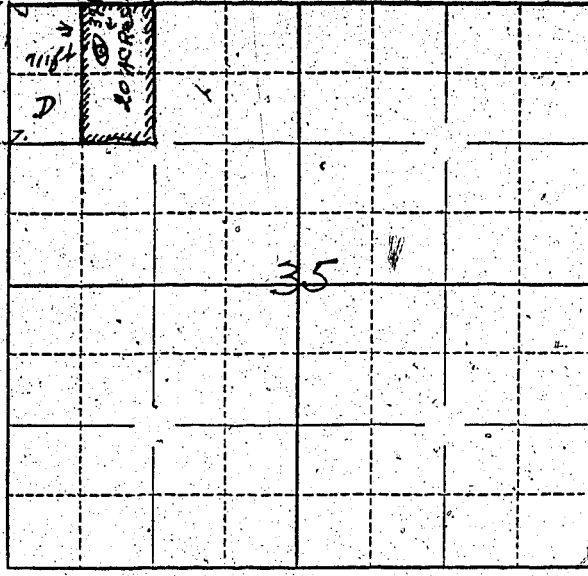

Locate well and acreage of irrigated land on plat.

Scale: ~~1/4~~ 1 Mile
4"

STATE OF OREGON

County of Josephine } ss.

I, Henry C. Gillock, being first duly sworn, do hereby certify that I have read the foregoing Registration Statement and that all of the items therein contained are true to the best of my knowledge and belief.

Henry C. Gillock
(Signature of Registrant)

Subscribed and sworn to before me this 19 day of June, 1958.

My commission expires My commission expires Aug. 2, 1958

Sam J. Dixon
(Notary Public)

(SEAL)

CERTIFICATE OF REGISTRATION

STATE OF OREGON

County of Marion } ss.

This is to certify that the foregoing Registration Statement was received in the office of the State Engineer on the 27th day of June, 1958, at 8:00 o'clock A.M. and has been duly recorded in said office in Book No. 8 of Registration Statements on page GR-1772

Witness my hand this 7th day of January, 1959

Lewis A. Stanley
(State Engineer)

By _____ (Deputy)

GR-1772

\$15.00