

Registration Statement

OF CLAIMANT OF RIGHT TO APPROPRIATE GROUND WATER

TO THE STATE ENGINEER OF OREGON:

I, ALTON E. Sawicki and Edith A.R. Sawicki
of R.L. Box 477 County of Josephine
(Mailing address)

State of Oregon do hereby make application for a certificate of registration as evidence of a right to appropriate ground water.

1. Source from which water is withdrawn is pump well
(Flowing well, pump well, infiltration trench, or tunnel)

2. Location is: 1 mi west end .8 mile north from Holland, Oregon
(Approximate distance and direction from nearest city or town)

and is more particularly described as follows:

(a) North 10 acres in the Southern half of the Northeast Quarter of the Northwest
(Give distance and bearing to corner of section or other legal subdivision)
being within NE 1/4 of NW 1/4 of Sec. 32, Twp. 39 S, Rge. 7 W
(Smallest legal subdivision) (N. or S.) (E. or W.)

or (b) within limits of recorded platted property, town or city:

in Lot _____, Block _____ of _____
(Name of plat or addition)
County of _____
(If within city or town, give name)

3. Construction Work was begun on 1944; was completed on 1944
(Date) (Date)

and the ground water claimed was first used for the purposes set out below on 1944
(Date)

since which time the water has been used continuously
(Continuously or intermittently)

from 1944 to 1958
(Date) (Date)

4. Quantity of water claimed and used is 60 gpd gallons per minute; _____ acre feet per year.

5. Purpose or Purposes for which water is used irrigation & domestic

(Domestic, irrigation, municipal, manufacturing, industrial, etc.)

6. Description of Well: Depth 21 feet. Type Dug
(Dug or drilled)

diameter 36 inches. Elevation of ground at well site 1450.5 ft feet, mean sea level.
(As near as known)

Depth to water table _____ feet. upper by 1/2 mile S. of Holland, Oregon

7. Capacity of Well: 60 gpd g.p.m. with 3 feet drawdown. This well

_____ g.p.m. with _____ feet drawdown. have pump installed

Date of test _____

If Flowing Well: Measured discharge _____ g.p.m. on _____
(Date)

Shut-in pressure at ground surface _____ lbs. per sq. in. on _____
(Date)

Water is controlled by _____
(Cap, valve, etc.)

8. Casing: (Give diameter, commercial specifications and depth below ground surface of each casing size.)

5 tiles 36" inch diameter *concrete tiles* from *top of well* to *18'* feet
 inch diameter from to feet
 inch diameter from to feet
 inch diameter from to feet

Describe and show depth of shoe, plug, adapter, liner or other details: *1*

9. Perforated Casings or Screens:

One - 36" diameter - 3 ft tile in bottom of well from *18'* to *21' down well*
(Number per foot and size of perforations, or describe screen)
 from to
 from to
 from to

10. Log of Well: (Describe each stratum or formation clearly, indicate if water bearing, and give thickness and depth as indicated.)

MATERIAL	Thickness (Feet)	Depth to Bottom (Feet)
<i>Top soil</i>	<i>3 ft</i>	
<i>Rocks and gravel</i>	<i>18 ft</i>	

If log of well is not available, give name and address of driller.

11. Infiltration Trench: Covered or open
 Dimensions: Length ft. Minimum depth ft. Maximum depth ft.

Bottom width ft. Discharge g.p.m. Date of test

12. Tunnel: Type of lining

Dimensions:
(Length, course, and cross sectional size)

Position of water bearing stratum with reference to portal of tunnel

Log of tunnel: (Preceding table for log of well may be used, if desired. Give footage from portal and character of materials, as pertinent.)

13. Pumping Equipment:

(a) Pump Motor No. *1 1/2" PLL 3* Capacity *60* g.p.m.
(Make, type and size)

(b) Motor *3 Horsepower - single phase electric*
(Type and horsepower)


14. Location of area irrigated or to be irrigated, or place of use if for purposes other than irrigation.

Township North or South	Range E. or W. of Willamette Meridian	Section	Forty-acre Tract	Number Acres To Be Irrigated	Date of Reclamation
<i>39 South</i>	<i>T west</i>	<i>23</i>	<i>NE 1/4 of NW 1/4</i>	<i>10 acres</i>	<i>1944</i>

15. If the ground water supply is supplemental to an existing water supply, identification of any application for a permit, permit, certificate or adjudicated right to appropriate water made or held by the registrant.

Water and water rights appertaining to the premises consisting, in any and all interest, in Water Right Certificate 5108, recorded as described at Page 9 of Book of Water Right certificates for Josephine Co., Ore.

Township 39S Range 7 West W.M.
North

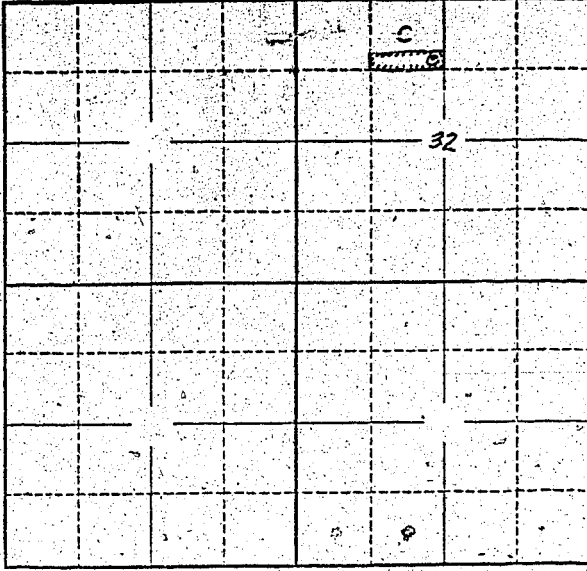

Locate well and acreage of irrigated land on plat.
Scale: 2" = 1 Mile

STATE OF OREGON

County of Josephine } ss.

I, Alton E Sowell and Edith A.R. Sowell, being first duly sworn, do hereby certify that I have read the foregoing Registration Statement and that all of the items therein contained are true to the best of my knowledge and belief.

Alton E Sowell
Edith A.R. Sowell
(Signature of Registrant)

Subscribed and sworn to before me this 7th day of June, 1958.

My commission expires Sept 26 1958

Wesley Lloyd
(Notary Public)

(SEAL)

CERTIFICATE OF REGISTRATION

STATE OF OREGON }
County of Marion } ss.

This is to certify that the foregoing Registration Statement was received in the office of the State Engineer on the 27th day of June, 1958, at 8:00 o'clock A.M. and has been duly recorded in said office in Book No. 8 of Registration Statements on page GR-1775.

Witness my hand this 7th day of January, 1959

Lewis A. Stanley
(State Engineer)

By _____
(Deputy)

\$15.00

GR - 1775