

Registration Statement

OF CLAIMANT OF RIGHT TO APPROPRIATE GROUND WATER

TO THE STATE ENGINEER OF OREGON:

I, Ray and Barbara Cleland
 of Rt. 1, Box 435, Albany County of Linn
(Mailing address)
 State of Oregon, do hereby make application for a certificate of registration as evidence
 of a right to appropriate ground water.

1. Source from which water is withdrawn is pump well #1
(Flowing well, pump well, infiltration trench, or tunnel)
 2. Location is: SE city limits of Brownsville, Oregon
(Approximate distance and direction from nearest city or town)

and is more particularly described as follows:

(a) 1762' S and 2211' E. of NW corner of S. 6, T. 14 S, R. 2 W.
(Give distance and bearing to corner of section or other legal subdivision)
 being within SE 1/4 of NW 1/4 of Sec. 6, Twp. 14 S, Rge. 2 W
(Smallest legal subdivision) (S. or S.) (E. or W.)

or (b) within limits of recorded platted property, town or city:

in Lot _____, Block _____ of _____
(Name of plat or addition)
 _____ County of Linn
(If within city or town, give name)

3. Construction Work was begun on 1947; was completed on 1947
(Date) (Date)

and the ground water claimed was first used for the purposes set out below on 1947
(Date)

since which time the water has been used Intermittently
(Continuously or intermittently)

from 1947 to August 3, 1958
(Date) (Date)

4. Quantity of water claimed and used is 80 gallons per minute; 60 acre
 feet per year.

5. Purpose or Purposes for which water is used Irrigation

(Domestic, irrigation, municipal, manufacturing, industrial, etc.)

6. Description of Well: Depth 70 feet. Type Drilled
(Dug or drilled)
 diameter 6 inches. Elevation of ground at well site 320 feet, mean sea level.
(As near as known)
 Depth to water table 15 feet.

7. Capacity of Well: _____ g.p.m. with _____ feet drawdown.
 _____ g.p.m. with _____ feet drawdown.

Date of test Not Tested

If Flowing Well: Measured discharge _____ g.p.m. on _____
(Date)

Shut-in pressure at ground surface _____ lbs. per sq. in. on _____
(Date)

Water is controlled by _____
(Cap, valve, etc.)

8. Casing: (Give diameter, commercial specifications and depth below ground surface of each casing size.)

6	inch diameter	steel casing	from	0	to	70	feet
	inch diameter		from		to		feet
	inch diameter		from		to		feet
	inch diameter		from		to		feet

Describe and show depth of shoe, plug, adapter, liner or other details: _____

9. Perforated Casings or Screens:

Slot perforations

(Number per foot and size of perforations, or describe screen)

from 20 to 70

from to

from to

from to

10. Log of Well: (Describe each stratum or formation clearly, indicate if water bearing, and give thickness and depth as indicated.)

[illegible]

Unknown

11. Infiltration Trench: Covered or open

Dimensions: Length ft. Minimum depth ft. Maximum depth ft.

Bottom width ft. Discharge g.p.m. Date of test

12. Tunnel: Type of lining

Dimensions: _____
(Length, course, and cross sectional size)

Position of water bearing stratum with reference to portal of tunnel.....

Log of tunnel: (Preceding table for log of well may be used, if desired. Give footage from portal and character of materials, as pertinent.)

13. Pumping Equipment:

(a) Pump Peerless Turbine Capacity 80 g.p.m.

(Make, type and size)

(b) Motor 5 H. P. Electric


(Type and horsepower)

14. Location of area irrigated or to be irrigated, or place of use if for purposes other than irrigation.

[illegible]

15. If the ground water supply is supplemental to an existing water supply, identification of any application for a permit, permit, certificate or adjudicated right to appropriate water made or held by the registrant.

Township 11 S Range 2 W, W.M.
North

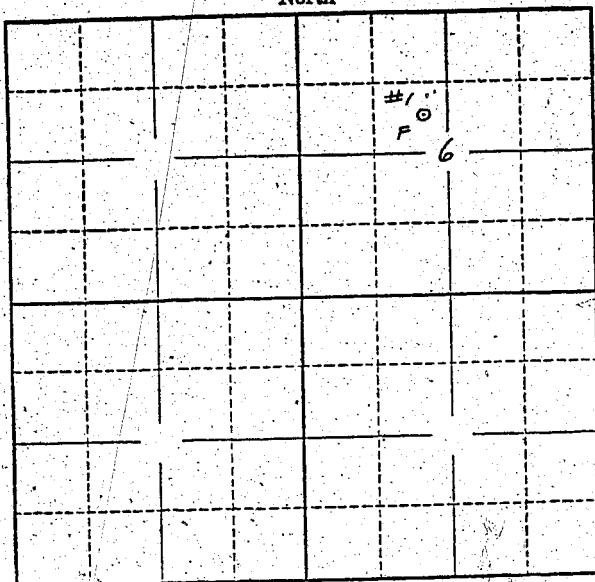

Locate well and acreage of irrigated land on plat.
Scale: 2" = 1 Mile

STATE OF OREGON

County of Linn

ss.

I, Ray and Barbara Cleland, being first duly sworn, do hereby certify that I have read the foregoing Registration Statement and that all of the items therein contained are true to the best of my knowledge and belief.

Ray Cleland Barbara Cleland
(Signature of Registrant)

Subscribed and sworn to before me this 25th day of June, 1958

My commission expires 2/19/59

Richard Carpenter
(Notary Public)

(SEAL)

CERTIFICATE OF REGISTRATION

STATE OF OREGON

County of Marion

ss.

This is to certify that the foregoing Registration Statement was received in the office of the State Engineer on the 27th day of June, 1958, at _____ o'clock _____ M. and has been duly recorded in said office in Book No. 8 of Registration Statements on page GR-1777

Witness my hand this 7th day of January, 1959

Lewis A. Stanley
(State Engineer)

By _____

(Deputy)

GR - 1777