

Registration Statement

OF CLAIMANT OF RIGHT TO APPROPRIATE GROUND WATER

TO THE STATE ENGINEER OF OREGON:

I, Robert P. Gates

of 1280 South Stage Road, Medford County of Jackson
(Mailing address)

State of Oregon, do hereby make application for a certificate of registration as evidence of a right to appropriate ground water.

1. Source from which water is withdrawn is pump well
(Flowing well, pump well, infiltration trench, or tunnel)

2. Location is: Approximately 2 miles south of Medford, Oregon
(Approximate distance and direction from nearest city or town)

and is more particularly described as follows:

(a) 1478 feet south and 291 feet east from the NE corner of DLG #50
(Give distance and bearing to corner of section or other legal subdivision)

being within NE $\frac{1}{4}$ NE $\frac{1}{4}$ SW $\frac{1}{4}$ of Sec. 1, Twp. 38 S., Rge. 2 W.
(Smallest legal subdivision) (N. or S.) (E. or W.)

or (b) within limits of recorded platted property, town or city:

in Lot _____, Block _____ of _____
(Name of plat or addition)
County of _____
(If within city or town, give name)

3. Construction Work was begun on 1950; was completed on 1950
(Date) (Date)

and the ground water claimed was first used for the purposes set out below on 1950
(Date)

since which time the water has been used continuously
(Continuously or intermittently)

from 1950 to present date
(Date) (Date)

4. Quantity of water claimed and used is 10 gallons per minute; 4.0 acre feet per year.

5. Purpose or Purposes for which water is used irrigation (commercial garden and orchard)

(Domestic, irrigation, municipal, manufacturing, industrial, etc.)

6. Description of Well: Depth 100 / est. feet. Type Drilled
(Dug or drilled)

diameter 6.0 inches. Elevation of ground at well site approx. 1500 feet, mean sea level.
(As near as known)

Depth to water table unknown feet.

7. Capacity of Well: unknown g.p.m. with unknown feet drawdown.
_____ g.p.m. with _____ feet drawdown.

Date of test not tested by present owner


If Flowing Well: Measured discharge _____ g.p.m. on _____
(Date)

Shut-in pressure at ground surface _____ lbs. per sq. in. on _____
(Date)

Water is controlled by _____
(Cap, valve, etc.)

Township 38 S, Range 2 W, W.M.

North Section 1

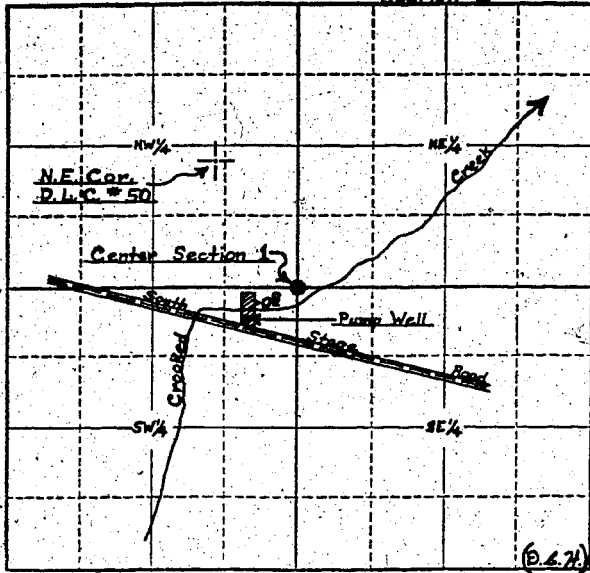

Locate well and acreage of irrigated land on plat.

Scale: 4" = 1 Mile

STATE OF OREGON

County of Jackson

} ss.

I, Robert P. Gates, being first duly sworn, do hereby certify that I have read the foregoing Registration Statement and that all of the items therein contained are true to the best of my knowledge and belief.

Robert P. Gates
(Signature of Registrant)

Subscribed and sworn to before me this 30th day of June, 1958

My commission expires July 31, 1959

Ediel Gault
(Notary Public)

(SEAL)

CERTIFICATE OF REGISTRATION

STATE OF OREGON

County of Marion

} ss.

This is to certify that the foregoing Registration Statement was received in the office of the State Engineer on the 27th day of June, 1958, at 8:00 o'clock A.M. and has been duly recorded in said office in Book No. 8 of Registration Statements on page GR-1780

Witness my hand this 7th day of January, 1959

Lewis A. Stanley
(State Engineer)

By _____ (Deputy)

15.00

GR-1780