

Registration Statement

OF CLAIMANT OF RIGHT TO APPROPRIATE GROUND WATER

TO THE STATE ENGINEER OF OREGON:

I, Werner J. Jarms
 of 5110 Portland Rd Salem County of Marion
(Mailing address)
 State of Oregon, do hereby make application for a certificate of registration as evidence of a right to appropriate ground water.

1. Source from which water is withdrawn is Pump Well
(Flowing well, pump well, infiltration trench, or tunnel)

2. Location is: 2 mi North of Salem City limits on Hg 99.5
(Approximate distance and direction from nearest city or town)

and is more particularly described as follows:

(a) 600' N + 170' E FROM MOST Westerly SW Corner of A. Stanton DLE #49
(Give distance and bearing to corner of section or other legal subdivision)

being within N.W. 1/4 S.W. 1/4 of Sec. 6, Twp. 7 S, Rge. 2 W
(Smallest legal subdivision) (N. or S.) (E. or W.)

or (b) within limits of recorded platted property, town or city:

in Lot _____, Block _____ of _____
(Name of plat or addition)
 _____ County of _____
(If within city or town, give name)

3. Construction Work was begun on Mar 9 - 1952; was completed on Mar 12 - 1959
(Date) (Date)

and the ground water claimed was first used for the purposes set out below on May 21 - 1952
(Date)

since which time the water has been used Intermittently
(Continuously or intermittently)

from May to Oct
(Date) (Date)

4. Quantity of water claimed and used is 28 gallons per minute; _____ acre feet per year.

5. Purpose or Purposes for which water is used irrigation + ~~drinking~~
(Domestic, irrigation, municipal, manufacturing, industrial, etc.)

6. Description of Well: Depth 90 feet. Type drilled
(Dug or drilled)

diameter 6 inches. Elevation of ground at well site 175 feet, mean sea level.
(As near as known)

Depth to water table 4.6 feet.

7. Capacity of Well: _____ g.p.m. with _____ feet drawdown.

_____ g.p.m. with _____ feet drawdown.


Date of test _____

If Flowing Well: Measured discharge _____ g.p.m. on _____
(Date)

Shut-in pressure at ground surface _____ lbs. per sq. in. on _____
(Date)

Water is controlled by _____
(Cap, valve, etc.)

Township 7S Range 2W, W.M.
North

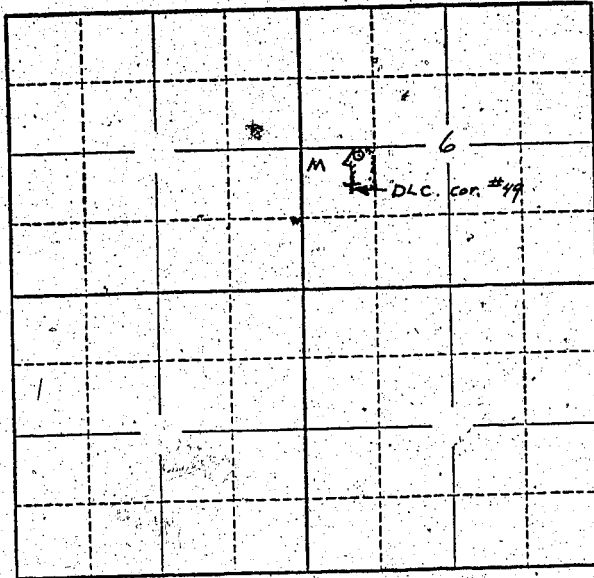

Locate well and acreage of irrigated land on plat.
Scale: 2" = 1 Mile

STATE OF OREGON

County of Marion } ss.

I, Werner J. Jarms, being first duly sworn, do hereby certify that I have read the foregoing Registration Statement and that all of the items therein contained are true to the best of my knowledge and belief.

Werner J. Jarms
(Signature of Registrant)

Subscribed and sworn to before me this 27th day of June 1958

My commission expires 12th June 1958 Wm. S. Bartholomew
(Notary Public)

(SEAL)

CERTIFICATE OF REGISTRATION

STATE OF OREGON

County of Marion } ss.

This is to certify that the foregoing Registration Statement was received in the office of the State Engineer on the 27th day of June 1958, at 11:30 o'clock A. M. and has been duly recorded in said office in Book No. 8 of Registration Statements on page GR-1781

Witness my hand this 7th day of January 1959

Lewis A. Stanley
(State Engineer)

\$15.00

By _____ (Deputy)

GR-1781