

Registration Statement

OF CLAIMANT OF RIGHT TO APPROPRIATE GROUND WATER

TO THE STATE ENGINEER OF OREGON:

I, MAX J. PEMBERTON

of 1980 S. 12TH Salem County of MARION

State of OREGON, do hereby make application for a certificate of registration as evidence of a right to appropriate ground water.

1. Source from which water is withdrawn is PUMP WELL
(Flowing well, pump well, infiltration trench, or tunnel)

2. Location is: SOUTH EDGE SALEM CITY LIMITS
(Approximate distance and direction from nearest city or town)

and is more particularly described as follows:

(a) 3100' S x 5' W from NE Corner Section 34
(Give distance and bearing to corner of section or other legal subdivision)

being within NE 1/4 SE 1/4 of Sec. 34, Twp. 7S, Rge. 3W
(Smallest legal subdivision) (E or S) (E or W)

or (b) within limits of recorded platted property, town or city:

in Lot _____, Block _____ of _____
(Name of plat or addition)

County of _____
(If within city or town, give name)

3. Construction Work was begun on 1925; was completed on 1925
(Date) (Date)

and the ground water claimed was first used for the purposes set out below on 1925
(Date)

since which time the water has been used CONTINUOUSLY
(Continuously or intermittently)

from 1925 to 1958
(Date) (Date)

4. Quantity of water claimed and used is 2.0 gallons per minute; _____ acre feet per year.

5. Purpose or Purposes for which water is used IRRIGATION OF NURSERY

(Domestic, irrigation, municipal, manufacturing, industrial, etc.)

6. Description of Well: Depth 22 feet. Type DRIVEN
(Dug or drilled)

diameter 4" inches. Elevation of ground at well site _____ feet, mean sea level.
(As near as known)

Depth to water table 8 feet.

7. Capacity of Well: _____ g.p.m. with NO TEST feet drawdown.

_____ g.p.m. with _____ feet drawdown.


Date of test _____

If Flowing Well: Measured discharge _____ g.p.m. on _____
(Date)

Shut-in pressure at ground surface _____ lbs. per sq. in. on _____
(Date)

Water is controlled by _____
(Cap, valve, etc.)

Township 7S Range 3W W.M.
North

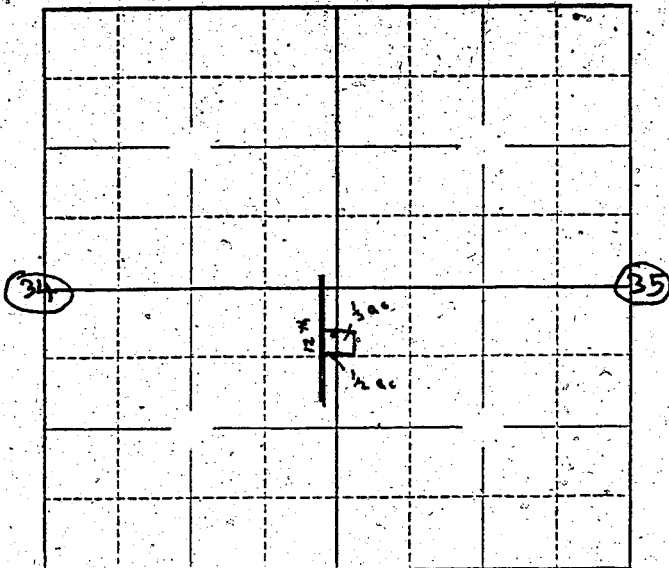

Locate well and acreage of irrigated land on plat.
Scale: $\frac{1}{4}$ " = 1 Mile

STATE OF OREGON

County of MARION } ss.

I, Max J. Pemberton, being first duly sworn, do hereby certify that I have read the foregoing Registration Statement and that all of the items therein contained are true to the best of my knowledge and belief.

Max J. Pemberton
(Signature of Registrant)

Subscribed and sworn to before me this 27th day of June, 1958.

My commission expires 12th June 1961 W.M.D. Bartholomew
(Notary Public)

(SEAL)

CERTIFICATE OF REGISTRATION

STATE OF OREGON

County of Marion } ss.

This is to certify that the foregoing Registration Statement was received in the office of the State Engineer on the 27th day of June, 1958, at 11:00 o'clock A. M. and has been duly recorded in said office in Book No. 8 of Registration Statements on page GR-1782

Witness my hand this 7th day of January, 1959

Lewis A. Stanley
(State Engineer)

\$15.00

By _____ (Deputy)

GR - 1782