

Registration Statement

OF CLAIMANT OF RIGHT TO APPROPRIATE GROUND WATER

TO THE STATE ENGINEER OF OREGON:

I, Maurice Nissen

of Route 1 Box 360 Silverton County of Marion

State of Oregon, do hereby make application for a certificate of registration as evidence of a right to appropriate ground water.

1. Source from which water is withdrawn is Pump Well
(Flowing well, pump well, infiltration trench, or tunnel)

2. Location is: 3 1/2 miles Northeast of Silverton.
(Approximate distance and direction from nearest city or town)

and is more particularly described as follows:

(a) S 87° 47' W 269.28' S 0° 20' W 1564.61' and East 96' from the Northeast corner
NW 1/4 NW 1/4 Sec 19 T6S R14E bearing to corner of section or other legal subdivision
being within W 1/2 of the NW 1/4 (SW 1/4 NW 1/4) of Sec. 19, Twp. 6S, Rge. 1E
(Smallest legal subdivision) (N. or S.) (E. or W.)

or (b) within limits of recorded platted property, town or city:

in Lot _____, Block _____ of _____
(Name of plat or addition)
County of Marion.
(If within city or town, give name)

3. Construction Work was begun on Aug. 1 1953; was completed on Aug. 21 1953
(Date) (Date)

and the ground water claimed was first used for the purposes set out below on Aug. 21, 1953
(Date)

since which time the water has been used intermittently
(Continuously or intermittently)

from Aug. 21, 1953 to Present
(Date) (Date)

4. Quantity of water claimed and used is 50 gallons per minute; _____ acre feet per year.

5. Purpose or Purposes for which water is used Irrigation

6. Description of Well: Depth 107 & 14 ft. filled back with coarse gravel.
(Domestic, irrigation, municipal, manufacturing, industrial, etc.)
feet, Type Drilled.
(Dug or drilled)

diameter 8" casing inches. Elevation of ground at well site _____ feet, mean sea level.
(As near as known)

Depth to water table 17 ft. feet.

7. Capacity of Well: 100 g.p.m. with 50 feet drawdown.

70 g.p.m. with 35 feet drawdown.

Date of test Aug. 21 1953

If Flowing Well: Measured discharge _____ g.p.m. on _____
(Date)

Shut-in pressure at ground surface _____ lbs. per sq. in. on _____
(Date)

Water is controlled by _____
(Cap, valve, etc.)

8. Casing: (Give diameter, commercial specifications and depth below ground surface of each casing size.)

8" inch diameter 5/16" Standard black pipe from Surface to 93 ft feet
 _____ inch diameter _____ from _____ to _____ feet
 _____ inch diameter _____ from _____ to _____ feet
 _____ inch diameter _____ from _____ to _____ feet

Describe and show depth of shoe, plug, adapter, liner or other details: _____

Shoe 93' down _____

9. Perforated Casings or Screens:

None from _____ to _____
 (Number per foot and size of perforations, or describe screen)
 _____ from _____ to _____
 _____ from _____ to _____
 _____ from _____ to _____

10. Log of Well: (Describe each stratum or formation clearly, indicate if water bearing, and give thickness and depth as indicated.)

MATERIAL	Thickness (Feet)	Depth to Bottom (Feet)
Top soil brown	2	2
Cobble stone and dirt	18	20
Cement gravel and some larger stones mixed	87	107
Bottom 14' is filled with coarse gravel.		

If log of well is not available, give name and address of driller. _____

11. Infiltration Trench: Covered or open _____

Dimensions: Length _____ ft. Minimum depth _____ ft. Maximum depth _____ ft.

Bottom width _____ ft. Discharge _____ g.p.m. Date of test _____

12. Tunnel: Type of lining _____

Dimensions: _____
(Length, course, and cross sectional size)

Position of water bearing stratum with reference to portal of tunnel _____

Log of tunnel: (Preceding table for log of well may be used, if desired. Give footage from portal and character of materials, as pertinent.)

13. Pumping Equipment:

(a) Pump Universal Jet 2 HP *D* Capacity 50 g.p.m.
(Make, type and size)


(b) Motor A.C. Smith Universal Jet 2 HP _____
(Type and horsepower)

14. Location of area irrigated or to be irrigated, or place of use if for purposes other than irrigation.

Township North or South	Range E. or W. of Willamette Meridian	Section	Forty-acre Tract	Number Acres To Be Irrigated	Date of Reclamation
6S	1 E	19	NW 1/4 NW 1/4	8.53	1953
6S	1 E	19	SW 1/4 NW 1/4	2.15	"
				10.68 AC	"

15. If the ground water supply is supplemental to an existing water supply, identification of any application for a permit, permit, certificate or adjudicated right to appropriate water made or held by the registrant.

Township 6 S. Range 1 E. W.M.
North

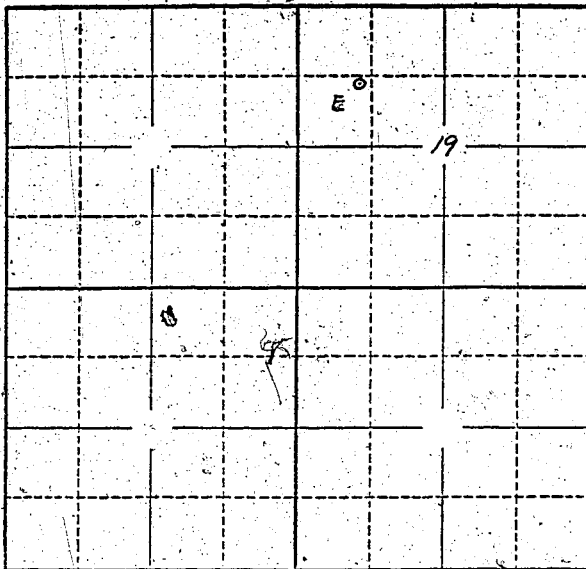

Locate well and acreage of irrigated land on plat.
Scale: 2" = 1 Mile

STATE OF OREGON

County of Marion } ss.

I, Maurice Nissen, being first duly sworn, do hereby certify that I have read the foregoing Registration Statement and that all of the items therein contained are true to the best of my knowledge and belief.

Maurice Nissen
(Signature of Registrant)

Subscribed and sworn to before me this 26th day of June, 1958

My commission expires Jan 18, 1962

Walter M. Henry
(Notary Public)

(SEAL)

CERTIFICATE OF REGISTRATION

STATE OF OREGON } ss.
County of Marion

This is to certify that the foregoing Registration Statement was received in the office of the State Engineer on the 27th day of June, 1958, at 1:00 o'clock P.M. and has been duly recorded in said office in Book No. 8 of Registration Statements on page GR-1783

Witness my hand this 7th day of January, 1959

Lewis A. Stanley
(State Engineer)

By _____
(Deputy)

\$15.00