

RECEIVED
MAY 11 1956
STATE ENGINEER
SALEM, OREGON

REGISTRATION NO. GR-184
CERTIFICATE NO. GR-170

Registration Statement

OF CLAIMANT OF RIGHT TO APPROPRIATE GROUND WATER

(Under Chapter 703, Oregon Laws 1955.)

TO THE STATE ENGINEER OF OREGON:

I, Henry H. and Edna M. Kirk
of Rt. 1, Box 65, Halsey County of Linn

State of Oregon do hereby make application for a certificate of registration as evidence of a right to appropriate ground water.

1. Source from which water is withdrawn is pump well
(Flowing well, pump well, infiltration trench, or tunnel)

2. Location is: 1 1/2 miles south and 3/4 miles east of Halsey, Oregon
(Approximate distance and direction from nearest city or town)

and is more particularly described as follows:

(a) 530' N. and 1090' West of the SE corner S. 7, T. 14 S., R. 3 W.M.
(Give distance and bearing to corner of section or other legal subdivision)

being within SE 1/4 of SE 1/4 of Sec. 7, Twp. 14 S., Rge. 3 W.
(Smallest legal subdivision) (N. or S.) (E. or W.)

or (b) within limits of recorded platted property, town or city:

in Lot 0 Block 0 of 0
(Name of plat or addition)

County of Linn
(If within city or town, give name)

3. Construction Work was begun on March 14, 1953; was completed on March 18, 1953
(Date) (Date)

and the ground water claimed was first used for the purposes set out below on May 15, 1953
(Date)

since which time the water has been used continuously
(Continuously or intermittently)

from May 15, 1953 to present time
(Date) (Date)

4. Quantity of water claimed and used is 180 gallons per minute; 107.5 acre feet per year.

5. Purpose or Purposes for which water is used Irrigation
(Domestic, irrigation, municipal, manufacturing, industrial, etc.)

6. Description of Well: Depth 123 feet. Type drilled
(Dug or drilled)

diameter 8 inches. Elevation of ground at well site 286 feet, mean sea level.
(As near as known)

Depth to water table 12 feet.

7. Capacity of Well: 230 g.p.m. with 100 feet drawdown.

0 g.p.m. with 0 feet drawdown.

Date of test March 18, 1953

If Flowing Well: Measured discharge 0 g.p.m. on 0 (Date)

Shut-in pressure at ground surface 0 lbs. per sq. in. on 0 (Date)

Water is controlled by 0 (Cap. valve, etc.)

8. Casing: (Give diameter, commercial specifications and depth below ground surface of each casing size.)

8 inch diameter steel casing from 0 to 110 feet
 inch diameter from to feet
 inch diameter from to feet
 inch diameter from to feet

Describe and show depth of shoe, plug, adapter, liner or other details:


9. Perforated Casings or Screens:

Slots - Mill perforater from 35 to 40
 (Number per foot and size of perforations, or describe screen)
 " " from 55 to 60
 " " from 80 to 98
 " " from 98 to 110

10. Log of Well: (Describe each stratum or formation clearly, indicate if water bearing, and give thickness and depth as indicated.)

MATERIAL	Thickness (Feet)	Depth to Bottom (Feet)
Brown clay	12	12
Conglomerate sand, clay & small rock	18	30
Water bearing rock	6	36
Conglomerate	12	48
Gravel	2	50
Clay and conglomerate	11	61
Blue clay	17	78
Gravel	2	80
Clay	15	95
Sand and gravel	14	109
Sand and clay	14	123

Township 14 S. Range 14 W., W.M.
North

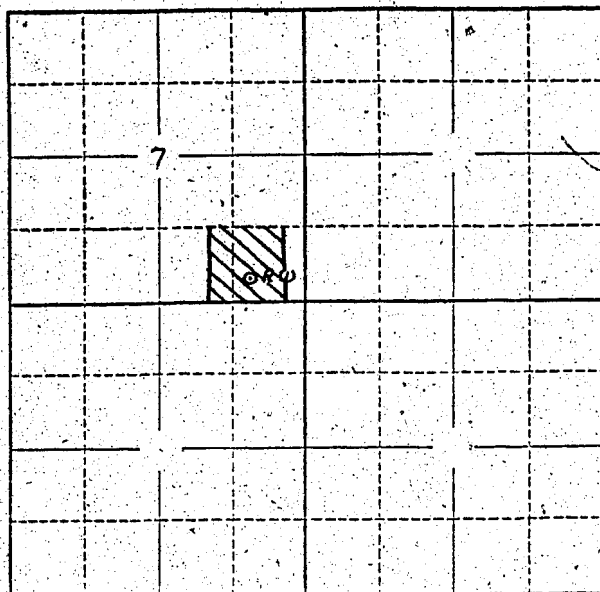

Locate well and acreage of irrigated land on plat.
Scale: 2" = 1 Mile

STATE OF OREGON

County of Linn } ss.

I, Henry H. and Edna M. Kirk, being first duly sworn, do hereby certify that I have read the foregoing Registration Statement and that all of the items therein contained are true to the best of my knowledge and belief.

Henry H. Kirk
Edna M. Kirk
(Signature of Registrant)

Subscribed and sworn to before me this 14th day of May, 1956

My commission expires 9-5-59
[Signature]
(Notary Public)

(SEAL)

CERTIFICATE OF REGISTRATION

STATE OF OREGON } ss.
County of Marion

This is to certify that the foregoing Registration Statement was received in the office of the State Engineer on the 11th day of May, 1956, at 8 o'clock A.M. and has been duly recorded in said office in Book No. 1 of Registration Statements on page GR-170 C


Witness my hand this 8th day of October, 1956
Lewis A. Stanley
(State Engineer)

By _____
(Deputy)

GR-170 C