

# Registration Statement

CERTIFICATE NO. \_\_\_\_\_

## OF CLAIMANT OF RIGHT TO APPROPRIATE GROUND WATER

(Under Chapter 708, Oregon Laws 1955.)

TO THE STATE ENGINEER OF OREGON:

I, Wesley Stinnett

of Rt 1 Box 161B Tanager County of Marion

State of Oregon, do hereby make application for a certificate of registration as evidence of a right to appropriate ground water.

1. Source from which water is withdrawn is Infiltration trench  
(Flowing well, pump well, infiltration trench, or tunnel)

2. Location is: 6 miles from Stayton  
(Approximate distance and direction from nearest city or town)

and is more particularly described as follows:

(a) 1610 feet west of 1450 feet north from SE corner Section 23  
(Give distance and bearing to corner of section or other legal subdivision)

being within NW 1/4 of SE 1/4 of Sec. 23, Twp. 9S, Rge. 2W  
(Smallest legal subdivision) (N, S, E, or W)

or (b) within limits of recorded platted property, town or city:

in Lot \_\_\_\_\_, Block \_\_\_\_\_ of \_\_\_\_\_  
(Name of plat or addition)

County of \_\_\_\_\_  
(If within city or town, give name)

3. Construction Work was begun on May 1 - 1948; was completed on May 2 1948  
(Date) (Date)

and the ground water claimed was first used for the purposes set out below on May 1948  
(Date)

since which time the water has been used intermittently during season  
(Continuously or intermittently)

from May 1948 to Oct. 1957  
(Date) (Date)

4. Quantity of water claimed and used is 2.16 gallons per minute; \_\_\_\_\_ acre feet per year.

5. Purpose or Purposes for which water is used Irrigation

6. Description of Well: Sump (Domestic, irrigation, municipal, manufacturing, industrial, etc.)  
Depth \_\_\_\_\_ feet. Type Dug (Dug or drilled)

diameter \_\_\_\_\_ inches. Elevation of ground at well site \_\_\_\_\_ feet, mean sea level.  
(As near as known)

Depth to water table 6 feet. Summer

7. Capacity of Well: \_\_\_\_\_ g.p.m. with \_\_\_\_\_ feet drawdown.

\_\_\_\_\_ g.p.m. with \_\_\_\_\_ feet drawdown.

Date of test \_\_\_\_\_

If Flowing Well: Measured discharge \_\_\_\_\_ g.p.m. on \_\_\_\_\_ (Date)

Shut-in pressure at ground surface \_\_\_\_\_ lbs. per sq. in. on \_\_\_\_\_ (Date)

Water is controlled by \_\_\_\_\_ (Cap, valve, etc.)

8. Casing: (Give diameter, commercial specifications and depth below ground surface of each casing size.)

..... inch diameter *not appl.* ..... from ..... to ..... feet  
 ..... inch diameter ..... from ..... to ..... feet  
 ..... inch diameter ..... from ..... to ..... feet  
 ..... inch diameter ..... from ..... to ..... feet

Describe and show depth of shoe, plug, adapter, liner or other details: .....

9. Perforated Casings or Screens:


..... *not appl.* ..... from ..... to .....  
 (Number per foot and size of perforations, or describe screen)  
 ..... from ..... to .....  
 ..... from ..... to .....  
 ..... from ..... to .....

10. Log of Well: (Describe each stratum or formation clearly, indicate if water bearing, and give thickness and depth as indicated.)

MATERIAL	Thickness (Feet)	Depth to Bottom (Feet)
<i>sand &amp; gravel</i>		



Township 9S Range 2W, W.M.  
North

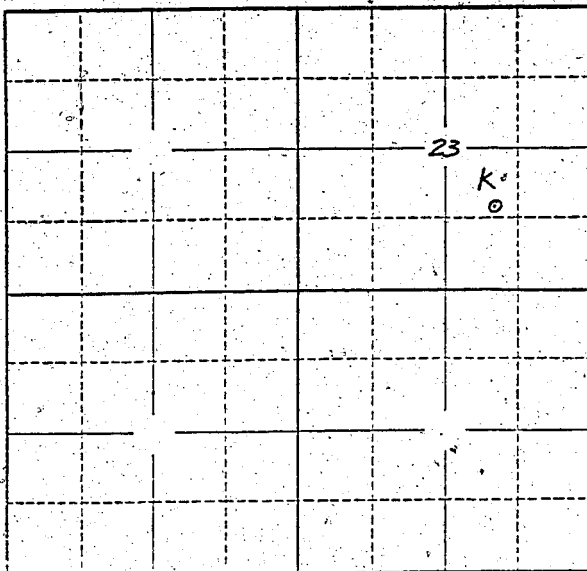

Locate well and acreage of irrigated land on plat.  
Scale: 2" = 1 Mile

STATE OF OREGON

County of Marion } ss.

I, Melvin Stinnett, being first duly sworn, do hereby certify that I have read the foregoing Registration Statement and that all of the items therein contained are true to the best of my knowledge and belief.

Melvin Stinnett  
(Signature of Registrant)

Subscribed and sworn to before me this 30th day of June, 1958

My commission expires 12th June 1961 Wm. S. Bartholomew  
(Notary Public)

(SEAL)

### CERTIFICATE OF REGISTRATION

STATE OF OREGON

County of Marion } ss.

This is to certify that the foregoing Registration Statement was received in the office of the State Engineer on the 30th day of June, 1958, at 3:00 o'clock P. M. and has been duly recorded in said office in Book No. 8 of Registration Statements on page GR-1785

~~Construction shall be completed by \_\_\_\_\_ and the water completely applied to beneficial use by \_\_\_\_\_~~

Witness my hand this 7th day of January, 1959

Lewis A. Stanley  
(State Engineer)

\$15.00

By \_\_\_\_\_ (Deputy)

GR-1785