

STATE ENGINEER  
SALE & LICENSE

REGISTRATION NO. GR-1845  
CERTIFICATE NO. GR-1789

# Registration Statement

## OF CLAIMANT OF RIGHT TO APPROPRIATE GROUND WATER

(Under Chapter 708, Oregon Laws 1955.)

TO THE STATE ENGINEER OF OREGON:

I, John B. Christensen & Betty Jo Christensen  
of Eugene Rt #2 Box 407 County of Lane

State of Oregon, do hereby make application for a certificate of registration as evidence of a right to appropriate ground water.

1. Source from which water is withdrawn is Pump Well #A  
(Flowing well, pump well, infiltration trench, or tunnel)

2. Location is: Cross Rds Lane - 5 mile Northwest of Coburg  
(Approximate distance and direction from nearest city or town)

and is more particularly described as follows: Well @

(a) Well is N 61° 32' W, 1883.9 feet from the S.E. Corner of the NW 1/4 of the SE 1/4 of Sec 11.  
(Give distance and bearing to corner of section or other legal subdivision)

being within SE 1/4 of the SW 1/4 of Sec. 11, Twp. 16 S., Rge. 4 W.  
(Smallest legal subdivision) (S or S.) (E or W.)

or (b) within limits of recorded platted property, town or city:

in Lot \_\_\_\_\_, Block \_\_\_\_\_ of \_\_\_\_\_  
(Name of plat or addition)

County of Lane  
(If within city or town, give name)

3. Construction Work was begun on June 1940; was completed on 1940  
(Date) (Date)

and the ground water claimed was first used for the purposes set out below on July 1940  
(Date)

since which time the water has been used Continuously  
(Continuously or intermittently)

from May 1940 to Oct 1957  
(Date) (Date)

4. Quantity of water claimed and used is 315 gallons per minute; 20 acre feet per year.

5. Purpose or Purposes for which water is used irrigation

(Domestic, irrigation, municipal, manufacturing, industrial, etc.)

6. Description of Well: Depth 18 feet. Type drilled - three 3" Pipes  
(Dug or drilled)

diameter \_\_\_\_\_ inches. Elevation of ground at well site 350 feet, mean sea level.  
(As near as known)

Depth to water table 6 feet.

7. Capacity of Well: \_\_\_\_\_ g.p.m. with \_\_\_\_\_ feet drawdown.

\_\_\_\_\_ g.p.m. with \_\_\_\_\_ feet drawdown.

Date of test \_\_\_\_\_

If Flowing Well: Measured discharge \_\_\_\_\_ g.p.m. on \_\_\_\_\_  
(Date)

Shut-in pressure at ground surface \_\_\_\_\_ lbs. per sq. in. on \_\_\_\_\_  
(Date)

Water is controlled by \_\_\_\_\_  
(Cap, valve, etc.)

*3-3 inch wells joined at surface to make one well*

8. Casing: (Give diameter, commercial specifications and depth below ground surface of each casing size.)

*3* inch diameter ..... from *0* to *18* feet  
..... inch diameter ..... from ..... to ..... feet  
..... inch diameter ..... from ..... to ..... feet  
..... inch diameter ..... from ..... to ..... feet

Describe and show depth of shoe, plug, adapter, liner or other details: .....

.....

9. Perforated Casings or Screens:

*2" x 1/4" slots* ..... from *12'* to *18'*  
(Number per foot and size of perforations, or describe screen) ..... from ..... to .....  
..... from ..... to .....  
..... from ..... to .....

10. Log of Well: (Describe each stratum or formation clearly, indicate if water bearing, and give thickness and depth as indicated.)

MATERIAL	Thickness (Feet)	Depth to Bottom (Feet)
<i>None</i>		

If log of well is not available, give name and address of driller. \_\_\_\_\_

11. Infiltration Trench: Covered or open \_\_\_\_\_

Dimensions: Length \_\_\_\_\_ ft. Minimum depth \_\_\_\_\_ ft. Maximum depth \_\_\_\_\_ ft.

Bottom width \_\_\_\_\_ ft. Discharge \_\_\_\_\_ g.p.m. Date of test \_\_\_\_\_

12. Tunnel: Type of lining \_\_\_\_\_

Dimensions: \_\_\_\_\_  
(Length, course, and cross sectional size)

Position of water bearing stratum with reference to portal of tunnel \_\_\_\_\_

Log of tunnel: (Preceding table for log of well may be used, if desired. Give footage from portal and character of materials, as pertinent.)

13. Pumping Equipment:

(a) Pump 3" Fairbanks centrifugal Capacity 360 g.p.m.  
(Make, type and size)


(b) Motor 1.5 hp Electric  
(Type and horsepower)

14. Location of area irrigated or to be irrigated, or place of use if for purposes other than irrigation.

Township North or South	Range E. or W. of Willamette Meridian	Section	Forty-acre Tract	Number Acres To Be Irrigated	Date of Reclamation
T16 S	R4 W	11	SE 1/4 of SW 1/4	8 <sup>2</sup>	1940

15. If the ground water supply is supplemental to an existing water supply, identification of any application for a permit, permit, certificate or adjudicated right to appropriate water made or held by the registrant.

Township 16 S Range 4 W, W.M.  
North

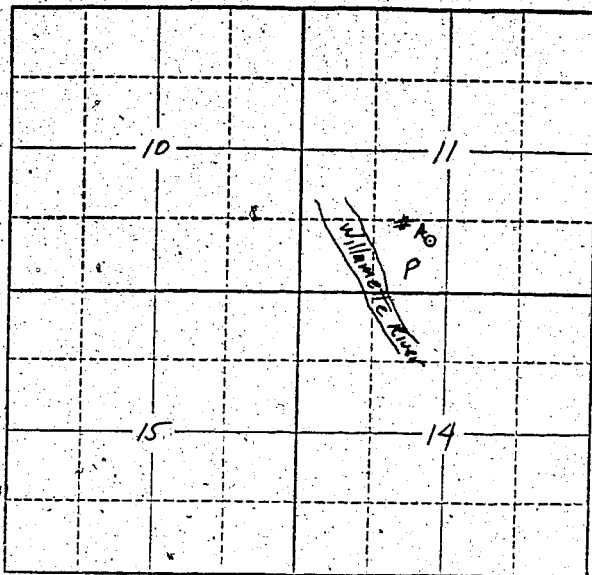

Locate well and acreage of irrigated land on plat.

Scale: 2" = 1 Mile

STATE OF OREGON

County of Linn } ss.

I, John B. + Betty G. Christensen, being first duly sworn, do hereby certify that I have read the foregoing Registration Statement and that all of the items therein contained are true to the best of my knowledge and belief.

John B. Christensen Betty G. Christensen  
(Signature of Registrant)

Subscribed and sworn to before me this 21 day of April, 1958

My commission expires 8/10/59  
Ray John  
(Notary Public)

(SEAL)

**CERTIFICATE OF REGISTRATION**

STATE OF OREGON

County of Marion } ss.

This is to certify that the foregoing Registration Statement was received in the office of the State Engineer on the 30th day of June, 1958, at 10:30 o'clock A.M. and has been duly recorded in said office in Book No. 8 of Registration Statements on page 6R-1789

~~Construction shall be completed by \_\_\_\_\_ 19\_\_\_\_ and the water completely applied to beneficial use by \_\_\_\_\_ 19\_\_\_\_~~

Witness my hand this 7<sup>th</sup> day of January, 1959

Lewis A. Stanley  
(State Engineer)

By \_\_\_\_\_  
(Deputy)

**GR-1789**

\$15.00