

RECEIVED  
STATE ENGINEER  
SALES DIVISION

REGISTRATION NO. GR-1846  
CERTIFICATE NO. GR-1790

# Registration Statement

## OF CLAIMANT OF RIGHT TO APPROPRIATE GROUND WATER

(Under Chapter 708, Oregon Laws 1955.)

TO THE STATE ENGINEER OF OREGON:

I, John B. Christensen & Betty Jo Christensen  
of Eugene Rt #2 Box 407 County of Lane

State of Oregon, do hereby make application for a certificate of registration as evidence of a right to appropriate ground water.

1. Source from which water is withdrawn is Pump Well # B  
(Flowing well, pump well, infiltration trench, or tunnel)

2. Location is: Cross Rds Lane - 5 miles Northwest of Coburg  
(Approximate distance and direction from nearest city or town)

and is more particularly described as follows: Well B

(a) Well is N68°12'W, 14224 ft. from the S.E. Corner of the W 1/2 of the S.E. 1/4 of Sec. 11, T. 16 S, R. 4 W  
(Give distance and bearing to corner of section or other legal subdivision)

being within S.E. 1/4 of the S.W. 1/4 of Sec. 11, Twp. 16 S, Rge. 4 W.W.M.  
(Smallest legal subdivision) (N. or S.) (E. or W.)

or (b) within limits of recorded platted property, town or city:

in Lot \_\_\_\_\_, Block \_\_\_\_\_ of \_\_\_\_\_  
(Name of plat or addition)

County of Lane  
(If within city or town, give name)

3. Construction Work was begun on June 1939; was completed on 1939  
(Date) (Date)

and the ground water claimed was first used for the purposes set out below on 1939  
(Date)

since which time the water has been used continuously  
(Continuously or intermittently)

from May 1939 to Oct 1957  
(Date) (Date)

4. Quantity of water claimed and used is 315 gallons per minute; 30 acre feet per year.

5. Purpose or Purposes for which water is used irrigation

(Domestic, irrigation, municipal, manufacturing, industrial, etc.)

6. Description of Well: Depth 20 1/2 feet. Type drilled - Four 2 1/2"  
(Dug or drilled)

diameter Pipes inches. Elevation of ground at well site 350 feet, mean sea level.  
(As near as known)

Depth to water table 8 feet.

7. Capacity of Well: \_\_\_\_\_ g.p.m. with \_\_\_\_\_ feet drawdown.

\_\_\_\_\_ g.p.m. with \_\_\_\_\_ feet drawdown.

Date of test \_\_\_\_\_

If Flowing Well: Measured discharge \_\_\_\_\_ g.p.m. on \_\_\_\_\_  
(Date)


Shut-in pressure at ground surface \_\_\_\_\_ lbs. per sq. in. on \_\_\_\_\_  
(Date)

Water is controlled by \_\_\_\_\_  
(Cap, valve, etc.)





Township 16 S Range 4 W, W.M.  
North

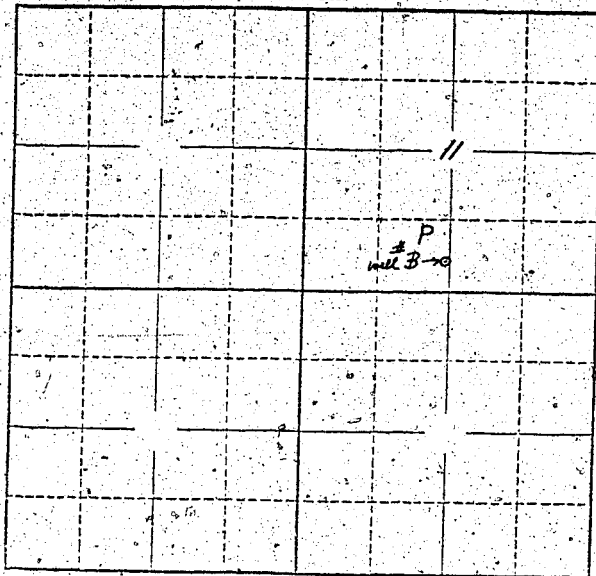

Locate well and acreage of irrigated land on plat.

Scale: 2" = 1 Mile

STATE OF OREGON

County of Linn } ss.

I, John B. & Betty Jo Christensen, being first duly sworn, do hereby certify that I have read the foregoing Registration Statement and that all of the items therein contained are true to the best of my knowledge and belief.

John B. Christensen & Betty Jo Christensen  
(Signature of Registrant)

Subscribed and sworn to before me this 21 day of April, 1958

My commission expires 8-10-59

Ray John  
(Notary Public)

(SEAL)

**CERTIFICATE OF REGISTRATION**

STATE OF OREGON

County of Marion } ss.

This is to certify that the foregoing Registration Statement was received in the office of the State Engineer on the 30th day of June, 1958, at 10:30 o'clock A.M. and has been duly recorded in said office in Book No. 8 of Registration Statements on page GR-1790

~~Construction shall be completed by \_\_\_\_\_ and the water completely applied to beneficial use by \_\_\_\_\_~~

Witness my hand this 7th day of January, 1959

Lewis A. Stanley  
(State Engineer)

\$15.00

By \_\_\_\_\_ (Deputy)

GR-1790