

Registration Statement

OF CLAIMANT OF RIGHT TO APPROPRIATE GROUND WATER

TO THE STATE ENGINEER OF OREGON:

I, Jahn B Christensen & Betty Jo Christensen
of Eugene Rt#2 Box 407 County of Lane
(Mailing address)

State of Oregon, do hereby make application for a certificate of registration as evidence of a right to appropriate ground water.

1. Source from which water is withdrawn is Pump Well
(Flowing well, pump well, infiltration trench, or tunnel)

2. Location is: 1 mi West of Coburg
(Approximate distance and direction from nearest city or town)

and is more particularly described as follows: Well "D"

(a) Well is N86°50'E 1939.9 ft. from the S.W. Corner of Nancy Ferguson PLC #43
(Give distance and bearing to corner of section or other legal subdivision)

being within NE 1/4 of the NW 1/4 of Sec. 32, Twp. 16 S, Rge. 3 W. Wm
(Smallest legal subdivision) (R or S) (W or W.)

or (b) within limits of recorded platted property, town or city:

in Lot _____, Block _____ of _____
(Name of plat or addition)

County of Lane
(If within city or town, give name)

3. Construction Work was begun on 1942; was completed on 1942
(Date) (Date)

and the ground water claimed was first used for the purposes set out below on 1942
(Date)

since which time the water has been used Continuously
(Continuously or intermittently)

from May 1940 to Oct. 1957
(Date) (Date)

4. Quantity of water claimed and used is 360 gallons per minute; 78 1/2 acre feet per year.

5. Purpose or Purposes for which water is used irrigation
(Domestic, irrigation, municipal, manufacturing, industrial, etc.)

6. Description of Well: Depth 21 1/2 feet. Type Drilled
(Dug or drilled)

diameter 5 inches. Elevation of ground at well site 350 feet, mean sea level.
(As near as known)

Depth to water table 9.2 feet.

7. Capacity of Well: _____ g.p.m. with _____ feet drawdown.

_____ g.p.m. with _____ feet drawdown.


Date of test _____

If Flowing Well: Measured discharge _____ g.p.m. on _____
(Date)

Shut-in pressure at ground surface _____ lbs. per sq. in. on _____
(Date)

Water is controlled by _____
(Cap. valve, etc.)

Township 16 S Range 3 W W.M.
North

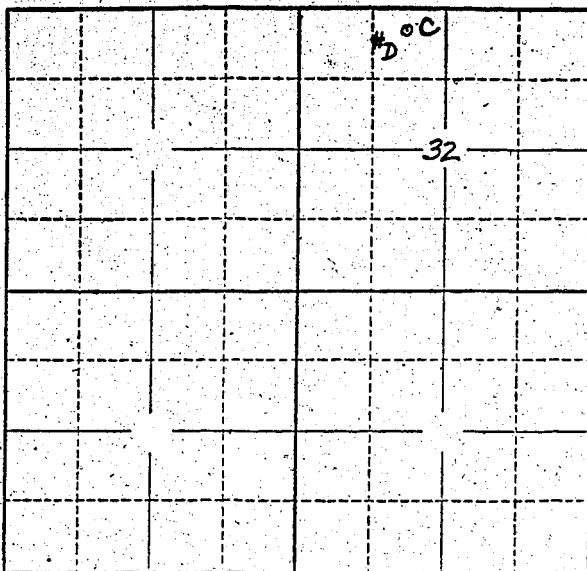

Locate well and acreage of irrigated land on plat.
Scale: 2" = 1 Mile

STATE OF OREGON

County of Linn } ss.

I, John B. + Betty J. Christensen, being first duly sworn, do hereby certify that I have read the foregoing Registration Statement and that all of the items therein contained are true to the best of my knowledge and belief.

John B. Christensen
(Signature of Registrant)

Subscribed and sworn to before me this 21 day of April, 1958

My commission expires 8/10/59
(Notary Public)

(SEAL)

CERTIFICATE OF REGISTRATION

STATE OF OREGON

County of Marion } ss.

This is to certify that the foregoing Registration Statement was received in the office of the State Engineer on the 30th day of June, 1958, at 10:30 o'clock A.M. and has been duly recorded in said office in Book No. 8 of Registration Statements on page GR-1793

Witness my hand this 26th day of January, 1959

Lewis A. Stank
(State Engineer)

\$15.00

By _____ (Deputy)