

Registration Statement

OF CLAIMANT OF RIGHT TO APPROPRIATE GROUND WATER

TO THE STATE ENGINEER OF OREGON:

I, R. J. Horn
of P.O. Box 495 Salem County of Marion
(Mailing address)

State of Oregon, do hereby make application for a certificate of registration as evidence of a right to appropriate ground water.

1. Source from which water is withdrawn is Pump well
(Flowing well, pump well, infiltration trench, or tunnel)

2. Location is: 9 miles N.E. of Salem
(Approximate distance and direction from nearest city or town)

and is more particularly described as follows:

(a) 1380 feet west & 2150 feet north from SE corner Section 26
(Give distance and bearing to corner of section or other legal subdivision)

being within NW 1/4 of SE 1/4 of Sec. 26, Twp. 6 S, Rge. 2 W
(Smallest legal subdivision) (T. or S.) (E. or W.)

or (b) within limits of recorded platted property, town or city:

in Lot _____, Block _____ of _____
(Name of plat or addition)
County of Marion
(If within city or town, give name)

3. Construction Work was begun on April 18, 1954, was completed on May 4, 1954
(Date) (Date)

and the ground water claimed was first used for the purposes set out below on May 1955
(Date)

since which time the water has been used intermittently during season
(Continuously or intermittently)

from May 1955 to Oct. 1957
(Date) (Date)

4. Quantity of water claimed and used is 66 gallons per minute; _____ acre feet per year.

5. Purpose or Purposes for which water is used Domestic & Irrigation

(Domestic, irrigation, municipal, manufacturing, industrial, etc.)

6. Description of Well: Depth 137 feet. Type drilled
(Dug or drilled)

diameter 8 inches inches. Elevation of ground at well site _____ feet, mean sea level.
(As near as known)

Depth to water table 32 feet.

7. Capacity of Well: 500 g.p.m. with 32 feet drawdown.

_____ g.p.m. with _____ feet drawdown.


Date of test _____

If Flowing Well: Measured discharge _____ g.p.m. on _____
(Date)

Shut-in pressure at ground surface _____ lbs. per sq. in. on _____
(Date)

Water is controlled by _____
(Cap, valve, etc.)

Township 6S Range 2W, W.M.
North

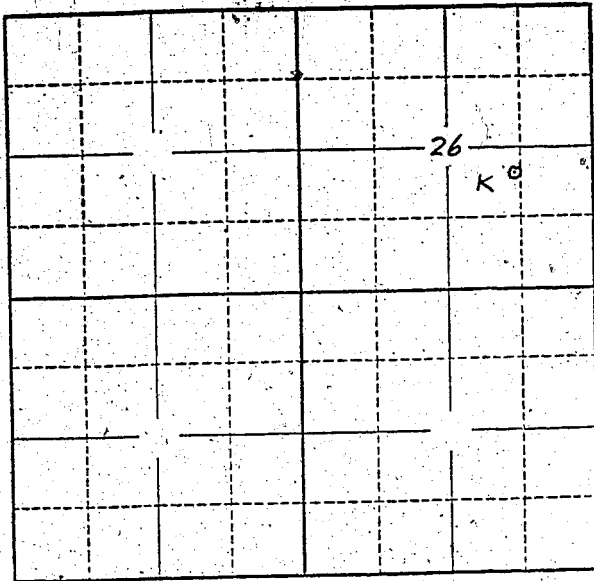

Locate well and acreage of irrigated land on plat.
Scale: 2" = 1 Mile

STATE OF OREGON }
County of Marion } ss.

I, R. J. Hanne, being first duly sworn, do hereby certify that I have read the foregoing Registration Statement and that all of the items therein contained are true to the best of my knowledge and belief.

R. J. Hanne
(Signature of Registrant)

Subscribed and sworn to before me this 30th day of June, 1958

My commission expires 12th June 1961

Wm. S. Bartholomew
(Notary Public)

(SEAL)

CERTIFICATE OF REGISTRATION

STATE OF OREGON }
County of Marion } ss.

This is to certify that the foregoing Registration Statement was received in the office of the State Engineer on the 30th day of June, 1958, at 12:00 o'clock A. M. and has been duly recorded in said office in Book No. 8 of Registration Statements on page GR-1795

Witness my hand this 26th day of January, 1959

Lewis A. Stearns
(State Engineer)

\$15.00

By _____ (Deputy)

GR-1795