REGISTRATION NO. GR-1852

CERTIFICATE NO. GR-1797

Registration Statement

OF CLAIMANT OF RIGHT TO APPROPRIATE GROUND WATER

(Under Chapter 708, Oregon Laws 1955.)

TO THE STATE ENGINEER OF OREGON:

I, Irene L. Rowland

of R.F.D. Box 180, Rickreall County of Polk

State of Oregon, do hereby make application for a certificate of registration as evidence of a right to appropriate ground water.

1. **Source** from which water is withdrawn is Pump well
(Flowing well, pump well, infiltration trench, or tunnel)

2. **Location** is: 4 mi. N.E. of Rickreall
(Approximate distance and direction from nearest city or town);

and is more particularly described as follows:

(a) N 27° 30' W 4130 feet of S.E. corner of Sec. 17
(Give distance and bearing to corner of section or other legal subdivision)

being within SW¼ of NE¼ (Smallest legal subdivision) of Sec. 17, Twp. 7 S (N. or S.), Rge. 4 W (E. or W.)

or (b) within limits of recorded platted property, town or city:

in Lot ....., Block ..... of .....
(Name of plat or addition)

..... (If within city or town, give name) County of .....

3. **Construction Work** was begun on 1946 (Date); was completed on 1946 (Date)

and the ground water claimed was first used for the purposes set out below on 1947 (Date),

since which time the water has been used Intermittently (Continuously or intermittently)

from June (Date) to October (Date)

4. **Quantity** of water claimed and used is 70 gallons per minute; 100 acre feet per year.

5. **Purpose or Purposes** for which water is used Irrigation
(Domestic, irrigation, municipal, manufacturing, industrial, etc.)

6. **Description of Well:** Depth 60 feet. Type Drilled (Dug or drilled)

diameter 6 inches. Elevation of ground at well site Unknown (As near as known) feet, mean sea level.

Depth to water table 15 feet.

7. **Capacity of Well:** 77 g.p.m. with 40 feet drawdown.

..... g.p.m. with ..... feet drawdown.

Date of test 1953

If Flowing Well: Measured discharge ..... g.p.m. on ..... (Date)

Shut-in pressure at ground surface ..... lbs. per sq. in. on ..... (Date)

Water is controlled by ..... (Cap, valve, etc.)

8. **Casing:** (Give diameter, commercial specifications and depth below ground surface of each casing size.)

6 inch diameter Steel casing from 0 to 60 feet

..... inch diameter ..... from ..... to ..... feet

..... inch diameter ..... from ..... to ..... feet

..... inch diameter ..... from ..... to ..... feet

Describe and show depth of shoe, plug, adapter, liner or other details: .....

9. **Perforated Casings or Screens:**

Unknown from ..... to .....
(Number per foot and size of perforations, or describe screen)

..... from ..... to .....

..... from ..... to .....

..... from ..... to .....

10. **Log of Well:** (Describe each stratum or formation clearly, indicate if water bearing, and give thickness and depth as indicated.)

MATERIAL	Thickness (Feet)	Depth to Bottom (Feet)
Unknown		

GR-1797

If log of well is not available, give name and address of driller. Unknown

11. **Infiltration Trench:** Covered or open .....

Dimensions: Length ..... ft. Minimum depth ..... ft. Maximum depth ..... ft.

Bottom width ..... ft. Discharge ..... g.p.m. Date of test .....

12. **Tunnel:** Type of lining .....

Dimensions: ..... (Length, course, and cross sectional size)

Position of water bearing stratum with reference to portal of tunnel .....

Log of tunnel: (Preceding table for log of well may be used, if desired. Give footage from portal and character of materials, as pertinent.)

13. **Pumping Equipment:**

(a) Pump Berkeley, deep well, 3 in. (Make, type and size) Capacity [redacted] 70 g.p.m.

(b) Motor 5 H.P. electric (Type and horsepower)

14. Location of area irrigated or to be irrigated, or place of use if for purposes other than irrigation.

Township North or South	Range E. or W. of Willamette Meridian	Section	Forty-acre Tract	Number Acres To Be Irrigated	Date of Reclamation
7	4	17	NE 1/4 of NW 1/4	16.5	1953
7	4	17	SE 1/4 of NW 1/4	22.6	1953
7	4	17	NW 1/4 of NE 1/4	14.9	1953
7	4	17	SW 1/4 of NE 1/4	30.1	1953
				84.1	

15. If the ground water supply is supplemental to an existing water supply, identification of any application for a permit, permit, certificate or adjudicated right to appropriate water made or held by the registrant.

GR-1797

Township 7 S, Range 4W, W.M.

North

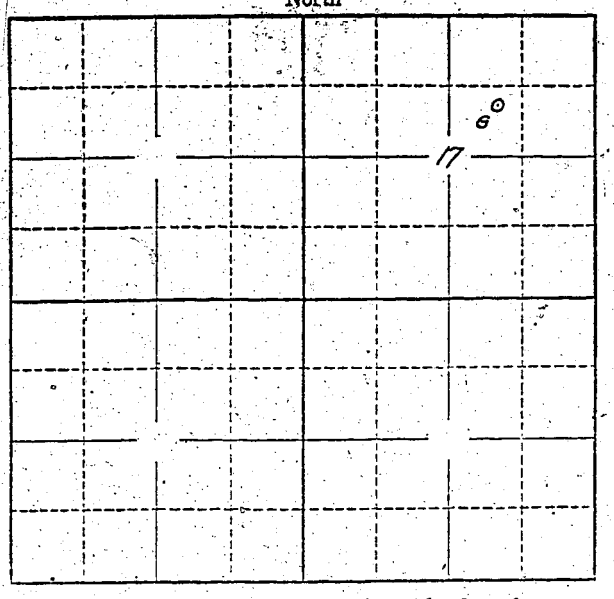

Locate well and acreage of irrigated land on plat.

Scale: 2" = 1 Mile

STATE OF OREGON
County of Marion } ss.

I, ..., being first duly sworn, do hereby certify that I have read the foregoing Registration Statement and that all of the items therein contained are true to the best of my knowledge and belief.

Irene L. Kirk
(Signature of Registrant)

Subscribed and sworn to before me this 30th day of June, 1958

My commission expires 12th June 1961 Wm. S. Bartholomew
(Notary Public)

(SEAL)

CERTIFICATE OF REGISTRATION

STATE OF OREGON
County of Marion } ss.

This is to certify that the foregoing Registration Statement was received in the office of the State Engineer on the 30th day of June, 1958, at 12 00 o'clock A M. and ~~has~~ been duly recorded in said office in Book No. 8 of Registration Statements on page GR-1797.

~~Construction shall be completed by ..... 19..., and the water completely applied to beneficial use by ..... 19...~~.

Witness my hand this 26th day of January, 1959.

Lewis A. Stitzel
(State Engineer)

$23.25

By .....
(Deputy)

GR-1797