

Registration Statement

REGISTRATION NO. GR-1853
CERTIFICATE NO. GR-3986

OF CLAIMANT OF RIGHT TO APPROPRIATE GROUND WATER

(Under Chapter 708, Oregon Laws 1955.)

TO THE STATE ENGINEER OF OREGON:

I, DAIRY COOPERATIVE ASSOCIATION
of 1313 S. SE. 12th Ave., Portland County of Multnomah
State of Oregon, do hereby make application for a certificate of registration as evidence
of a right to appropriate ground water.

- Source from which water is withdrawn is pump well
(Flowing well, pump well, infiltration trench, or tunnel)
- Location is: within Portland City Limits
(Approximate distance and direction from nearest city or town)

and is more particularly described as follows:

(a) Portland - Location - 2700 S. E. 7th - 200' E Clinton - 6th
(Give distance and bearing to corner of section or other legal subdivision)
being within TAX LOT 99 of Sec. 11, Twp. 1 S - 2 E, Rge. 1 E
(Smallest legal subdivision) (E. or S.) (E. or W.)

or (b) within limits of recorded platted property, town or city:
in Lot _____ Block _____ of _____
(Name of plat or addition)
County of _____
(If within city or town, give name)

3. Construction Work was begun on _____; was completed on January, 1946
(Date) (Date)
and the ground water claimed was first used for the purposes set out below on January, 1946
(Date)
since which time the water has been used continuously
(Continuously or intermittently)
from January, 1946 to _____ Date _____
(Date) (Date)

4. Quantity of water claimed and used is 750 gallons per minute; _____ acre
feet per year.

5. Purpose or Purposes for which water is used manufacturing
(Domestic, irrigation, municipal, manufacturing, industrial, etc.)

6. Description of Well: Depth 490 feet. Type drilled
(Dug or drilled)
diameter 16 inches. Elevation of ground at well site 20' feet, mean sea level.
(As near as known)
Depth to water table don't know feet.

7. Capacity of Well: 750 g.p.m. with Not Known feet drawdown.
_____ g.p.m. with _____ feet drawdown.

Date of test _____

If Flowing Well: Measured discharge not flowing g.p.m. on _____
(Date)

Shut-in pressure at ground surface _____ lbs. per sq. in. on _____
(Date)

Water is controlled by _____
(Cap, valve, etc.)

8. Casing: (Give diameter, commercial specifications and depth below ground surface of each casing size.)

16 inch diameter from 0 to 450 feet
 - inch diameter from - to - feet
 - inch diameter from - to 7 feet
 - inch diameter from - to - feet

Describe and show depth of shoe, plug, adapter, liner or other details:

9. Perforated Casings or Screens:

Casing Perforated from 105 to 115
(Number per foot and size of perforations, or describe screen)
 Description not Available from 221 to 230
 from 245 to 255
 from 419 to 425

10. Log of Well: (Describe each stratum or formation clearly, indicate if water bearing, and give thickness and depth as indicated.)

MATERIAL	Thickness (Feet)	Depth to Bottom (Feet)
Surface	12	12
Loose Dry Gravel	15	27
Gravel and Boulders	15	42
Cemented Gravel	76	118
Fine Sand and Water	3	121
Cemented Gravel	72	193
Sand with Water	24	217
Loose Gravel	2	219
Cemented Gravel	38	257
Clay and Fine Sand	5	262
Blue Clay	50	312
Brown Clay	3	315
Sand	8	323
Green Soap Stone	7	330
Dry Sand	3	333
Blue Clay	3	335
Brown Clay	4	339
Sand	39	378
Brown Clay	12	390
Brown Clay and Gravel	5	395
Sandy Clay	14	409
Grey Sand	5	414
Gravel - Sand and Water	8	422
Shale	67	489

GR-3986

If log of well is not available, give name and address of driller.

11. Infiltration Trench: Covered or open none

Dimensions: Length ft. Minimum depth ft. Maximum depth ft.

Bottom width ft. Discharge g.p.m. Date of test

12. Tunnel: Type of lining

Dimensions:
(Length, course, and cross sectional size)

Position of water bearing stratum with reference to portal of tunnel

Log of tunnel: (Preceding table for log of well may be used, if desired. Give footage from portal and character of materials, as pertinent.)

13. Pumping Equipment:

(a) Pump *Pomona - Turbin 8"* Capacity *750* g.p.m.
(Make, type and size)


(b) Motor *60 HP - US*
(Type and horsepower)

14. Location of area irrigated or to be irrigated, or place of use if for purposes other than irrigation.

Township North or South	Range E. or W. of Willamette Meridian	Section	Forty-acre Tract	Number Acres To Be Irrigated	Date of Reclamation
T1S	R1E	11	NW 1/4 of NW 1/4	Industrial Uses	1946

15. If the ground water supply is supplemental to an existing water supply, identification of any application for a permit, permit, certificate or adjudicated right to appropriate water made or held by the registrant.

Township 15 Range 1E W.M.
North

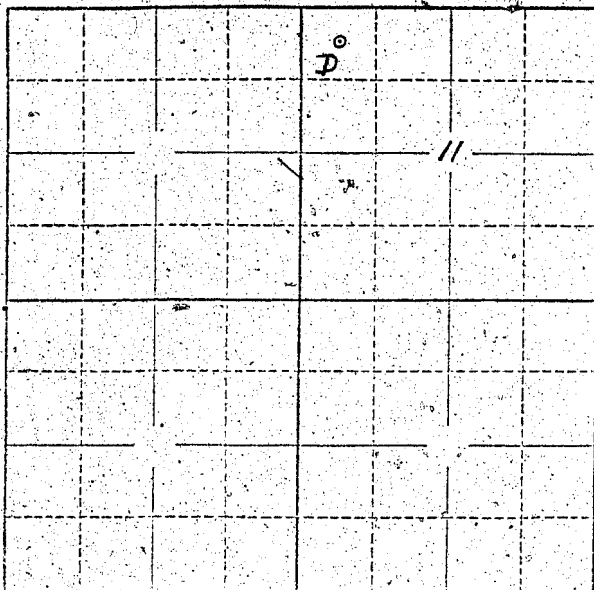

Locate well and acreage of irrigated land on plat.
Scale: 2" = 1 Mile

STATE OF OREGON

County of Multnomah } ss.

I, W. A. Boice, being first duly sworn, do hereby certify that I have read the foregoing Registration Statement and that all of the items therein contained are true to the best of my knowledge and belief.

DAIRY COOPERATIVE ASSOCIATION

W. A. Boice
(Signature of Registrant)

Subscribed and sworn to before me this 27 day of June, 1958

My commission expires Notary Public in and for the State of Oregon
My Commission Expires Sept. 30, 1958

R. E. Chisler
(Notary Public)

(SEAL)

CERTIFICATE OF REGISTRATION

STATE OF OREGON

County of Marion } ss.

This is to certify that the foregoing Registration Statement was received in the office of the State Engineer on the 30th day of June, 1958, at 8:00 o'clock A.M. and has been duly recorded in said office in Book No. 16 of Registration Statements on page GR-3986

~~Construction shall be completed by _____ of _____ and the water completely applied to beneficial use by _____ of _____.~~

Witness my hand this 15 day of February, 1960

Laura A. Stanley
(State Engineer)

By _____ (Deputy)

GR-3986

\$22.00