

RECEIVED  
JUN 10 1953  
STATE ENGINEER  
SALEM, OREGON

# Registration Statement

REGISTRATION NO. GR-1852  
CERTIFICATE NO. GR-1798

## OF CLAIMANT OF RIGHT TO APPROPRIATE GROUND WATER

(Under Chapter 708, Oregon Laws 1955.)

TO THE STATE ENGINEER OF OREGON:

I, Oregon State Highway Commission (State Parks Division)

of Marion County of Oregon

do hereby make application for a certificate of registration as evidence of a right to appropriate ground water.

1. Source from which water is withdrawn is Pump well  
(Flowing well, pump well, infiltration trench, or tunnel)

2. Location is: 3 miles south of Coburg along Market Road No. 41  
(Approximate distance and direction from nearest city or town)

and is more particularly described as follows:

(a) 1140' south and 1160' west of the NE corner of Sec. 9  
(Give distance and bearing to corner of section or other legal subdivision)

being within NE $\frac{1}{4}$  of NE $\frac{1}{4}$  of Sec. 9, Twp. 17 S, Rge. 3 W  
(Smallest legal subdivision) (N. or S.) (E. or W.)

or (b) within limits of recorded platted property, town or city:

in Lot \_\_\_\_\_, Block \_\_\_\_\_ of \_\_\_\_\_  
(Name of plat or addition)

County of Lane  
(If within city or town, give name)

3. Construction Work was begun on May 1949; was completed on May 1949  
(Date) (Date)

and the ground water claimed was first used for the purposes set out below on 1950  
(Date)  
since which time the water has been used Continuously for domestic. Intermittently for irrigation  
(Continuously or Intermittently)

from 1950 to Date  
(Date) (Date)

4. Quantity of water claimed and used is 30 gallons per minute; \_\_\_\_\_ acre feet per year. Additional 30 G.P.M. will be required for park expansion.

5. Purpose or Purposes for which water is used Domestic (Foreman's house and picnic area use)

Irrigation (Playfields and ground buildings)  
(Domestic, irrigation, municipal, manufacturing, industrial, etc.)

6. Description of Well: Depth 85.5 feet. Type Drilled  
(Dug or drilled)

diameter 6 inches. Elevation of ground at well site 412 feet; mean sea level.  
(As near as known)

Depth to water table 16 feet.

7. Capacity of Well: 100 g.p.m. with 34 feet drawdown.

\_\_\_\_\_ g.p.m. with \_\_\_\_\_ feet drawdown.

Date of test May 31, 1949

If Flowing Well: Measured discharge \_\_\_\_\_ g.p.m. on \_\_\_\_\_  
(Date)

Shut-in pressure at ground surface \_\_\_\_\_ lbs. per sq. in. on \_\_\_\_\_  
(Date)

Water is controlled by \_\_\_\_\_  
(Cap. valve, etc.)

8. Casing: (Give diameter, commercial specifications and depth below ground surface of each casing size.)

6 inch diameter Standard well casing from surface to 43.2 feet  
 inch diameter from to feet  
 inch diameter from to feet  
 inch diameter from to feet

Describe and show depth of shoe, plug, adapter, liner or other details: not known

9. Perforated Casings or Screens:

not known from to  
(Number per foot and size of perforations, or describe screen)  
 from to  
 from to  
 from to

10. Log of Well: (Describe each stratum or formation clearly, indicate if water bearing, and give thickness and depth as indicated.)

MATERIAL	Thickness (Feet)	Depth to Bottom (Feet)
Loose Gravel	16	16
Loose Gravel, water bearing	4	20
Boulders, " "	4	24
Loose Gravel, " "	14	38
Cement Gravel, " "	8	46
Course Gravel, " "	6	52
Cement Gravel, " "	33½	85½

If log of well is not available, give name and address of driller.

11. Infiltration Trench: Covered or open

Dimensions: Length \_\_\_\_\_ ft. Minimum depth \_\_\_\_\_ ft. Maximum depth \_\_\_\_\_ ft.  
Bottom width \_\_\_\_\_ ft. Discharge \_\_\_\_\_ g.p.m. Date of test \_\_\_\_\_

12. Tunnel: Type of lining \_\_\_\_\_

Dimensions: \_\_\_\_\_  
(Length, course, and cross sectional size)

Position of water bearing stratum with reference to portal of tunnel \_\_\_\_\_

Log of tunnel: (Preceding table for log of well may be used, if desired. Give footage from portal and character of materials, as pertinent.)

13. Pumping Equipment:

(a) Pump Fairbanks-Morse, Model #3006 D.P., Jet. Capacity 30 g.p.m.  
(Make, type and size)


(b) Motor 3 H.P. Electric single phase  
(Type and horsepower)

14. Location of area irrigated or to be irrigated, or place of use if for purposes other than irrigation.

Township North or South	Range E. or W. of Willamette Meridian	Section	Forty-acre Tract	Number Acres To Be Irrigated	Date of Reclamation
17 S	3 W	9	NE $\frac{1}{4}$ NE $\frac{1}{4}$	10 Ac. lawn	
17 S	3 W	9	NW $\frac{1}{4}$ NE $\frac{1}{4}$	2 AC. Lawn & Shrubs	
17 S	3 W	9	N $\frac{1}{2}$ NE $\frac{1}{4}$	General public park purposes.	

15. If the ground water supply is supplemental to an existing water supply, identification of any application for a permit, permit, certificate or adjudicated right to appropriate water made or held by the registrant.

Township 17S Range 3W W.M.  
North

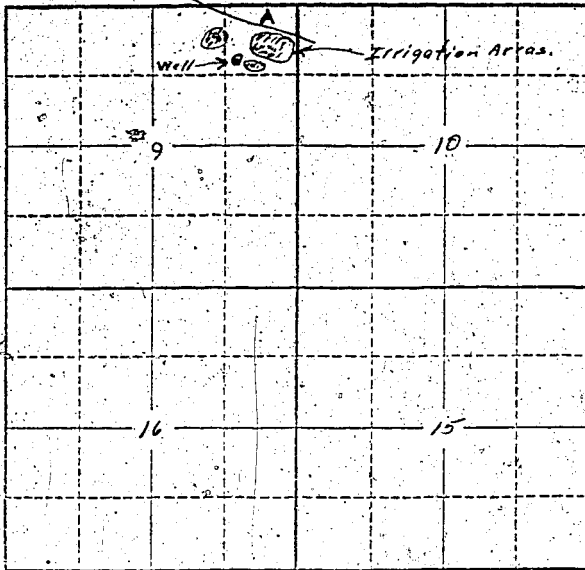

Locate well and acreage of irrigated land on plat.  
Scale: 2" = 1 Mile

STATE OF OREGON

County of Marion

ss.

I, C. H. Armstrong, being first duly sworn, do hereby certify that I have read the foregoing Registration Statement and that all of the items therein contained are true to the best of my knowledge and belief.

[Signature]  
(Signature of Registrant)  
State Parks Superintendent

Subscribed and sworn to before me this 19th day of June, 1957

My commission expires 4-19-61

[Signature]  
(Notary Public)

(SEAL)

**CERTIFICATE OF REGISTRATION**

STATE OF OREGON

County of Marion

ss.

This is to certify that the foregoing Registration Statement was received in the office of the State Engineer on the 30th day of June, 1957, at 5:00 o'clock A. M. and has been duly recorded in said office in Book No. 8 of Registration Statements on page GR-1798

~~Construction shall be completed by 10/1/58 and the contract shall be applied to~~  
~~the date of the above 10/1/58~~

Witness my hand this 26th day of January, 1959

[Signature]  
(State Engineer)

#1500

By [Signature]  
(Deputy)

GR-1798