

RECEIVED
JUN 10 1955
STATE ENGINEER
SALEM, OREGON

Registration No. GR-1858

Certificate No. GR-1799

Registration Statement

OF CLAIMANT OF RIGHT TO APPROPRIATE GROUND WATER

TO THE STATE ENGINEER OF OREGON:

I, Mrs. Tessa Watkins

of Route 1, Jefferson County of Linn

(Mailing address)

State of Oregon, do hereby make application for a certificate of registration as evidence of a right to appropriate ground water.

1. Source from which water is withdrawn is Pump well No. 1

(Flowing well, pump well, infiltration trench, or tunnel)

2. Location is: 3 miles East of Jefferson, Oregon

(Approximate distance and direction from nearest city or town)

and is more particularly described as follows:

(a) S. 27° 30' E. 24.6 Chains from NW corner of S. 17, T. 10 S., R. 2 W.

(Give distance and bearing to corner of section or other legal subdivision)

being within SW $\frac{1}{4}$ of NW $\frac{1}{4}$ of Sec. 17, Twp. 10 S., Rge. 2 W.

(Smallest legal subdivision)

(N. or S.)

(E. or W.)

or (b) within limits of recorded platted property, town or city:

in Lot _____, Block _____ of _____

(Name of plat or addition)

County of Linn

(If within city or town, give name)

3. Construction Work was begun on June 1940; was completed on June 1940

(Date)

(Date)

and the ground water claimed was first used for the purposes set out below on June 1940

(Date)

since which time the water has been used Continuously

(Continuously or intermittently)

from June 1940 to present time

(Date)

(Date)

4. Quantity of water claimed and used is 400 gallons per minute; 232.5 acre feet per year.

5. Purpose or Purposes for which water is used Irrigation

(Domestic, irrigation, municipal, manufacturing, industrial, etc.)

6. Description of Well: Depth 21 feet. Type Drilled

(Dug or drilled)

diameter 10 inches. Elevation of ground at well site 250 feet, mean sea level.

(As near as known)

Depth to water table 17 feet.

7. Capacity of Well: _____ g.p.m. with _____ feet drawdown.

_____ g.p.m. with _____ feet drawdown.

Date of test not tested

If Flowing Well: Measured discharge _____ g.p.m. on _____

(Date)

Shut-in pressure at ground surface _____ lbs. per sq. in. on _____

(Date)

Water is controlled by _____

(Cap. valve, etc.)

8. Casing: (Give diameter, commercial specifications and depth below ground surface of each casing size.)

10 inch diameter Steel Casing from 0 to 21 feet
 inch diameter from to feet
 inch diameter from to feet
 inch diameter from to feet

Describe and show depth of shoe, plug, adapter, liner or other details:

9. Perforated Casings or Screens:

Slot perforations from 13 to 21
(Number per foot and size of perforations, or describe screen)
 from to
 from to
 from to

10. Log of Well: (Describe each stratum or formation clearly, indicate if water bearing, and give thickness and depth as indicated.)

MATERIAL	Thickness (Feet)	Depth to Bottom (Feet)
Not available		

If log of well is not available, give name and address of driller. Bill Hamilton Drilling Co.,

638 E. Third Avenue, Albany, Oregon

11. Infiltration Trench: Covered or open _____

Dimensions: Length _____ ft. Minimum depth _____ ft. Maximum depth _____ ft.

Bottom width _____ ft. Discharge _____ g.p.m. Date of test _____

12. Tunnel: Type of lining _____

Dimensions: _____
(Length, course, and cross sectional size)

Position of water bearing stratum with reference to portal of tunnel _____

Log of tunnel: (Preceding table for log of well may be used, if desired. Give footage from portal and character of materials, as pertinent.)

13. Pumping Equipment:

(a) Pump Fairbanks Morse 3rd Centrifugal Capacity 400 g.p.m.
(Make, type and size)


(b) Motor 20 H.P. Electric
(Type and horsepower)

14. Location of area irrigated or to be irrigated, or place of use if for purposes other than irrigation.

Township North or South	Range E. or W. of Willamette Meridian	Section	Forty-acre Tract	Number Acres To Be Irrigated	Date of Reclamation
10 S	2 W	17	SW $\frac{1}{4}$ of NW $\frac{1}{4}$	32.0	June 1940
10 S	2 W	17	NW $\frac{1}{4}$ of NW $\frac{1}{4}$	38.2	June 1940
10 S	2 W	17	NE $\frac{1}{4}$ of NW $\frac{1}{4}$	6.3	June 1940
10 S	2 W	17	SE $\frac{1}{4}$ of NW $\frac{1}{4}$	1.0	June 1940
				77.5	

15. If the ground water supply is supplemental to an existing water supply, identification of any application for a permit, permit, certificate or adjudicated right to appropriate water made or held by the registrant.

Township 10 S Range 2 W, W.M.
North

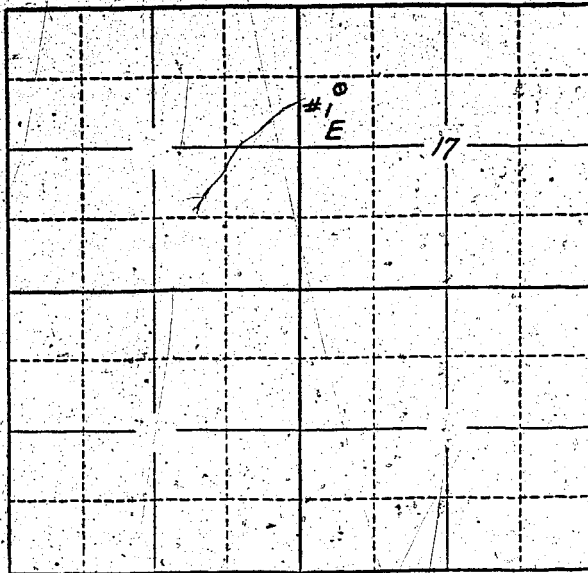

Locate well and acreage of irrigated land on plat.
Scale: 2" = 1 Mile

STATE OF OREGON

County of Linn } ss.

I, Mrs. Tessa Watkins, being first duly sworn, do hereby certify that I have read the foregoing Registration Statement and that all of the items therein contained are true to the best of my knowledge and belief.

Mrs. Tessa Watkins
(Signature of Registrant)

Subscribed and sworn to before me this 26 day of June, 1958

My commission expires MY COMMISSION EXPIRES JUNE 30, 1959

Vern M Swartz
(Notary Public)

(SEAL)

CERTIFICATE OF REGISTRATION

STATE OF OREGON

County of Marion } ss.

This is to certify that the foregoing Registration Statement was received in the office of the State Engineer on the 30th day of June, 1958, at 8:00 o'clock A.M. and has been duly recorded in said office in Book No. 8 of Registration Statements on page GR-1799

Witness my hand this 26th day of January, 1959

Lewis A. Stanley
(State Engineer)

22-20

By _____ (Deputy)

GR-1799