

# Registration Statement

## OF CLAIMANT OF RIGHT TO APPROPRIATE GROUND WATER

TO THE STATE ENGINEER OF OREGON:

I, Mrs. Tessa Watkins

of Route 1, Jefferson County of Linn

(Mailing address)

State of Oregon, do hereby make application for a certificate of registration as evidence of a right to appropriate ground water.

1. Source from which water is withdrawn is Pump Well No. 2  
(Flowing well, pump well, infiltration trench, or tunnel)

2. Location is: 3 miles East of Jefferson, Oregon  
(Approximate distance and direction from nearest city or town)

and is more particularly described as follows:

(a) S. 81° 40' E. 27.7 chains from NW corner of S. 17, T. 10 S., R. 2 W.  
(Give distance and bearing to corner of section or other legal subdivision)

being within NE 1/4 of NW 1/4 of Sec. 17, Twp. 10 S, Rge. 2 W  
(Smallest legal subdivision) (N. or S.) (E. or W.)

or (b) within limits of recorded platted property, town or city:

in Lot \_\_\_\_\_, Block \_\_\_\_\_ of \_\_\_\_\_  
(Name of plat or addition)

County of Linn  
(If within city or town, give name)

3. Construction Work was begun on April 1944; was completed on April 1944  
(Date) (Date)

and the ground water claimed was first used for the purposes set out below on April 1944  
(Date)

since which time the water has been used Continuously  
(Continuously or intermittently)

from April 1944 to present time  
(Date) (Date)

4. Quantity of water claimed and used is 300 gallons per minute; 37.5 acre feet per year.

5. Purpose or Purposes for which water is used Irrigation

(Domestic, irrigation, municipal, manufacturing, industrial, etc.)

6. Description of Well: Depth 21 feet. Type Drilled  
(Dug or drilled)

diameter 10 inches. Elevation of ground at well site 250 feet, mean sea level.  
(As near as known)

Depth to water table \_\_\_\_\_ feet.

7. Capacity of Well: \_\_\_\_\_ g.p.m. with \_\_\_\_\_ feet drawdown.

\_\_\_\_\_ g.p.m. with \_\_\_\_\_ feet drawdown.

Date of test Not tested

If Flowing Well: Measured discharge \_\_\_\_\_ g.p.m. on \_\_\_\_\_  
(Date)


Shut-in pressure at ground surface \_\_\_\_\_ lbs. per sq. in. on \_\_\_\_\_  
(Date)

Water is controlled by \_\_\_\_\_  
(Cap, valve, etc.)





Township 10 S Range 2 W, W.M.  
North

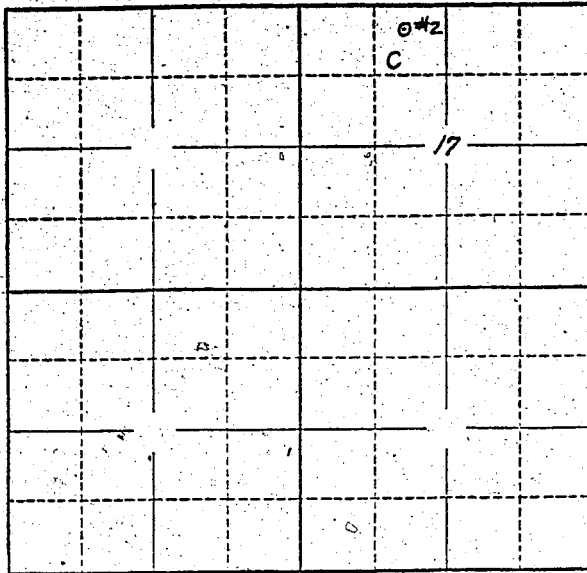

Locate well and acreage of irrigated land on plat.  
Scale: 2" = 1 Mile

STATE OF OREGON

County of Linn } ss.

I, Mrs. Tessa Watkins, being first duly sworn, do hereby certify that I have read the foregoing Registration Statement and that all of the items therein contained are true to the best of my knowledge and belief.

Mrs. Tessa Watkins  
(Signature of Registrant)

Subscribed and sworn to before me this 26 day of June, 1958  
My commission expires MY COMMISSION EXPIRES JUNE 30, 1959  
Vera M Swartz  
(Notary Public)

(SEAL)

**CERTIFICATE OF REGISTRATION**

STATE OF OREGON

County of Marion } ss.

This is to certify that the foregoing Registration Statement was received in the office of the State Engineer on the 26<sup>th</sup> day of June, 1958, at 6:00 o'clock A.M. and has been duly recorded in said office in Book No. B of Registration Statements on page GR-1800

Witness my hand this 26<sup>th</sup> day of January, 1959.

Leura A. Stanley  
(State Engineer)

By \_\_\_\_\_ (Deputy)

#1500

GR - 1800