

RECEIVED
MAY 14 1956
STATE ENGINEER
SALEM, OREGON

REGISTRATION NO. GR-186
CERTIFICATE NO. GR-172

Registration Statement

OF CLAIMANT OF RIGHT TO APPROPRIATE GROUND WATER

(Under Chapter 708, Oregon Laws 1955.)

TO THE STATE ENGINEER OF OREGON:

I, David W. and Dora E. Blakeley
of Rt. 2, Box 195, Albany County of Linn

State of Oregon, do hereby make application for a certificate of registration as evidence of a right to appropriate ground water.

- Source from which water is withdrawn is DUMP Well
(Flowing well, pump well, infiltration trench, or tunnel)
- Location is: 9 miles NE Albany, Oregon
(Approximate distance and direction from nearest city or town)

and is more particularly described as follows:

(a) N. 58° 45' E. 39 chains from the SW corner of the North half of the
(Give distance and bearing to corner of section or other legal subdivision)
Lewis Cox D.L.C. #44 in T. 10 S., R. 2 W. M. in Linn County Oregon
being within N82 of SW2 of Sec. 29 Twp. 10 S. Rge. 2 W.
(Smallest legal subdivision) (N. or S.) (E. or W.)

or (b) within limits of recorded platted property, town or city:

in Lot _____, Block _____ of _____
(Name of plat or addition)
County of Linn
(If within city or town, give name)

- Construction Work was begun on 1945; was completed on 1945
(Date) (Date)

and the ground water claimed was first used for the purposes set out below on 1945
(Date)

since which time the water has been used continuously
(Continuously or intermittently)
from 1945 to present time
(Date) (Date)

- Quantity of water claimed and used is 260 gallons per minute; 28 acre feet per year.

- Purpose or Purposes for which water is used Irrigation

(Domestic, irrigation, municipal, manufacturing, industrial, etc.)

- Description of Well: Depth 24 feet. Type Driven
(Dug or drilled)

diameter 3 1/2 inches. Elevation of ground at well site 245 feet, mean sea level.
(As near as known)

Depth to water table 8 feet.

- Capacity of Well: 350 g.p.m. with 12 feet drawdown.
_____ g.p.m. with _____ feet drawdown.

Date of test Not tested

If Flowing Well: Measured discharge _____ g.p.m. on _____
(Date)

Shut-in pressure at ground surface _____ lbs. per sq. in. on _____
(Date)

Water is controlled by _____
(Cap, valve, etc.)

If log of well is not available, give name and address of driller.

11. Infiltration Trench: Covered or open

Dimensions: Length ft. Minimum depth ft. Maximum depth ft.

Bottom width ft. Discharge g.p.m. Date of test

12. Tunnel: Type of lining

Dimensions:
(Length, course, and cross sectional size)

Position of water bearing stratum with reference to portal of tunnel

Log of tunnel: (Preceding table for log of well may be used, if desired. Give footage from portal and character of materials, as pertinent.)

13. Pumping Equipment:

(a) Pump Denum 2 1/2" centrifugal Capacity 350 g.p.m.
(Make, type and size)

(b) Motor 15 H. P. electric motor
(Type and horsepower)

14. Location of area irrigated or to be irrigated, or place of use if for purposes other than irrigation.


Township North or South	Range E. or W. of Willamette Meridian	Section	Forty-acre Tract	Number Acres To Be Irrigated	Date of Reclamation
10 S	2 W	29	SE 1/4 of NW 1/4	4.0	1945
10 S	2 W	29	NE 1/4 of SW 1/4	7.2	1945
				11.2	

143-180

Beginning at an iron pipe in the center of a ditch which is East 36.44 chains distant and North 13.20 chains distant from the SW corner of the N half of the D.L.C. of Lewis Cox and wf. same being Not. No. 1626 and Cl. 44 in T. 10 S., R 2 W. etc.; thence N. 69°15' W. along the center of said ditch 8.04 chains to the center of a road; thence N. 1° E. 8.77 chains to an iron bolt; thence N. 1°22' E. 8.22 chain to an iron pipe; thence N. 1°45' W. 6.46 chains to the N. line of said Cl; thence N. 61°30' E. along the N line of said cl. to a point due n of the p.l.b. thence 30.24 chs to the p.l.b. containing 19.77 acres more or less excepting therefrom a strip of land 8 ft. wide off of the W side of the entire length of the above 19.77 acres reserved for a roadway.

15. If the ground water supply is supplemental to an existing water supply, identification of any application for a permit, permit, certificate or adjudicated right to appropriate water made or held by the registrant.

Township 10S. Range 2W. W.M.
North

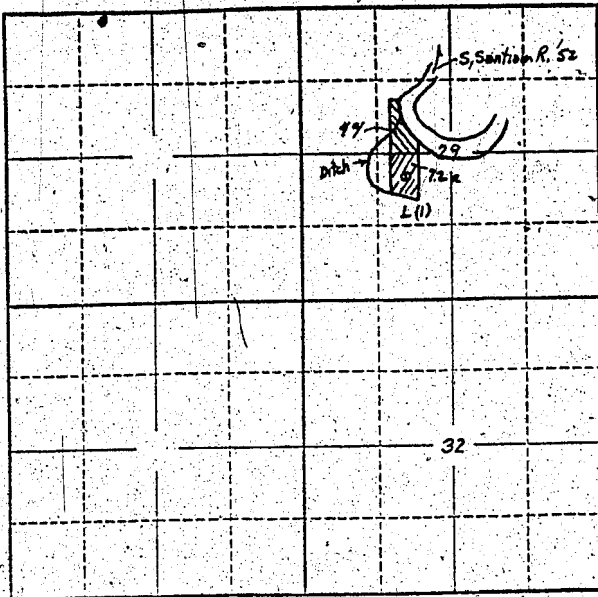

Locate well and acreage of irrigated land on plat.
Scale: 2" = 1 Mile

STATE OF OREGON

County of Linn

ss.

I, David W. and Dora E. Blakeley, being first duly sworn, do hereby certify that I have read the foregoing Registration Statement and that all of the items therein contained are true to the best of my knowledge and belief.

David W. Blakeley

Dora E. Blakeley
(Signature of Registrant)

Subscribed and sworn to before me this 11th day of May, 1956

My commission expires Aug 4, 1957

Saronalee Strait
(Notary Public)

(SEAL)

CERTIFICATE OF REGISTRATION

STATE OF OREGON

County of Marion

ss.

This is to certify that the foregoing Registration Statement was received in the office of the State Engineer on the 11th day of May, 1956, at 8 o'clock A.M. and has been duly recorded in said office in Book No. 1 of Registration Statements on page GR-172 C.

Witness my hand this 8th day of October, 1956.

Levirio A. Stanley
(State Engineer)

By

(Deputy)

GR-172 C