

RECEIVED
JUN 30 1958

STATE ENGINEER
SALEM, OREGON

Registration No. GR. 1820
Certificate No. GR. 1801

Registration Statement

OF CLAIMANT OF RIGHT TO APPROPRIATE GROUND WATER

TO THE STATE ENGINEER OF OREGON:

I, John F. and Katie M. Grenz and George V. Grenz

of Route 2, Box 428, Albany County of Linn
(Mailing address)

State of Oregon, do hereby make application for a certificate of registration as evidence of a right to appropriate ground water.

1. Source from which water is withdrawn is Pump Well No. 2
(Flowing well, pump well, infiltration trench, or tunnel)

2. Location is: 1/2 mile south of Jefferson, Oregon
(Approximate distance and direction from nearest city or town)

and is more particularly described as follows:

(a) N. 42° 10' E. 7.75 chains from the SW corner of SE 1/4, S. 11, T. 10 S., R. 3 W.
(Give distance and bearing to corner of section or other legal subdivision)

being within SW 1/4 of SE 1/4 of Sec. 11, Twp. 10 S, Rge. 3 W
(Smallest legal subdivision) (N. or S.) (E. or W.)

or (b) within limits of recorded platted property, town or city:

in Lot _____, Block _____ of _____
(Name of plat or addition)

County of Linn
(If within city or town, give name)

3. Construction Work was begun on 1946; was completed on 1946
(Date) (Date)

and the ground water claimed was first used for the purposes set out below on 1946
(Date)

since which time the water has been used continuously
(Continuously or intermittently)

from 1946 to present time
(Date) (Date)

4. Quantity of water claimed and used is 220 gallons per minute; 30 acre feet per year.

5. Purpose or Purposes for which water is used Irrigation

(Domestic, irrigation, municipal, manufacturing, industrial, etc.)

6. Description of Well: Depth 27 feet. Type Drilled
(Dug or drilled)

diameter 6 inches. Elevation of ground at well site 215 feet, mean sea level.
(As near as known)

Depth to water table 16 feet.

7. Capacity of Well: 250 g.p.m. with 4 feet drawdown.

_____ g.p.m. with _____ feet drawdown.

Date of test 1946

If Flowing Well: Measured discharge _____ g.p.m. on _____
(Date)

Shut-in pressure at ground surface _____ lbs. per sq. in. on _____
(Date)

Water is controlled by _____
(Cap, valve, etc.)

8. Casing: (Give diameter, commercial specifications and depth below ground surface of each casing size.)

6 inch diameter steel casing from 0 to 27 feet
 inch diameter from to feet
 inch diameter from to feet
 inch diameter from to feet

Describe and show depth of shoe, plug, adapter, liner or other details:

9. Perforated Casings or Screens:

Slot perforations from 21 to 27
(Number per foot and size of perforations, or describe screen)
 from to
 from to
 from to

10. Log of Well: (Describe each stratum or formation clearly, indicate if water bearing, and give thickness and depth as indicated.)

MATERIAL	Thickness (Feet)	Depth to Bottom (Feet)
Not available		

If log of well is not available, give name and address of driller. Cy. Burkhardt, Albany, Oregon

11. Infiltration Trench: Covered or open

Dimensions: Length ft. Minimum depth ft. Maximum depth ft.
 Bottom width ft. Discharge g.p.m. Date of test

12. Tunnel: Type of lining

Dimensions:
(Length, course, and cross sectional size)

Position of water bearing stratum with reference to portal of tunnel

Log of tunnel: (Preceding table for log of well may be used, if desired. Give footage from portal and character of materials, as pertinent.)

13. Pumping Equipment:

(a) Pump Gardner-Denver 2" centrifugal Capacity 250 g.p.m.
(Make, type and size)


(b) Motor 15 H. P. electric
(Type and horsepower)

14. Location of area irrigated or to be irrigated, or place of use if for purposes other than irrigation.

Township North or South	Range E. or W. of Williams' Meridian	Section	Forty-acre Tract	Number Acres To Be Irrigated	Date of Reclamation
10 S	3 W	11	SW $\frac{1}{4}$ of SE $\frac{1}{4}$	6.6	1946
10 S	3 W	11	SE $\frac{1}{4}$ of SW $\frac{1}{4}$	3.0	"
10 S	3 W	14	NE $\frac{1}{4}$ of NW $\frac{1}{4}$	0.2	"
10 S	3 W	14	NW $\frac{1}{4}$ of NE $\frac{1}{4}$	2.2	"
				12.0	

Beginning at a point in a slough from which point a 3/8" Iron bolt on the right bank of said slough bears N.79° 22'E. 0.679 chain, said beginning point being South 7.551 chains and West 16.933 chains from the Southeast corner of the Jacob L. Miller D.L.C.No.61 in T.10 S. R. 3 W. of the Will. Mer. in Linn County, Oregon; and running thence N.42° 50'W. along the afore said slough 11.751 chains to a point from which a 1/2" Iron bolt bears N.58° 02'E. 0.513 chain, thence N.58° 02'E. 12.688 chains to a 5/8"x1-3/8" U Iron bar, thence N.20° 10'W. 3.569 chains to a 1/2" Iron pipe, thence N.65° 44'E. 24.981 chains to a point at the Santiam River from which point a 1/2" Iron pipe bears S.65° 44'W. 2.250 chains, thence along the West side of said river S.19° 13'W. 32.600 chains, S.12° 00'W. 8.323 chains to a post in concrete levee, thence N.47° 44'W. 15.036 chains to a 5/8" Iron bolt on the right bank of a slough, thence S.79° 22'W. 0.679 chain to the place of beginning, containing 53.4 acres.

Township 10 S Range 3 W W.M.
North

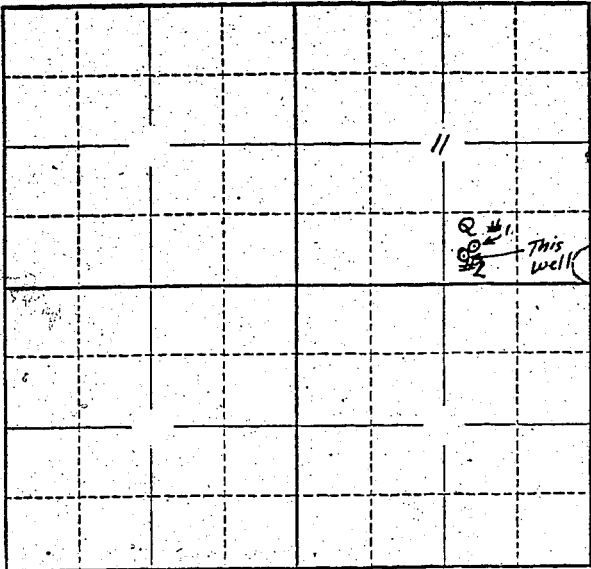

Locate well and acreage of irrigated land on plat.
Scale: 2" = 1 Mile

STATE OF OREGON }
County of LINN } ss.

I, John E. and Katie M. Grenz & George V. Grenz, being first duly sworn, do hereby certify that I have read the foregoing Registration Statement and that all of the items therein contained are true to the best of my knowledge and belief.

John E. Grenz Katie M. Grenz
(Signature of Registrant)

Subscribed and sworn to before me this 25th day of June, 1957.

My commission expires _____
MY COMMISSION EXPIRES JULY 25, 1960

Walter A. Shores
(Notary Public)

(SEAL)

CERTIFICATE OF REGISTRATION

STATE OF OREGON }
County of Marion } ss.

This is to certify that the foregoing Registration Statement was received in the office of the State Engineer on the 30th day of June, 1958, at 8:00 o'clock A.M. and has been duly recorded in said office in Book No. 8 of Registration Statements on page GR-1801

Witness my hand this 26th day of January

Lewis A. Stanley
(State Engineer)

\$15.00

By _____
(Deputy)

GR-1801