

Registration No. GR - 1861

Certificate No. GR - 1802

Registration Statement

OF CLAIMANT OF RIGHT TO APPROPRIATE GROUND WATER

TO THE STATE ENGINEER OF OREGON:

I, John F. and Katie M. Grenz and George V. Grenz

of Route 2, Box 428, Albany County of Linn
(Mailing address)

State of Oregon, do hereby make application for a certificate of registration as evidence of a right to appropriate ground water.

1. Source from which water is withdrawn is Pump well No. 1
(Flowing well, pump well, infiltration trench, or tunnel)

2. Location is: 1/2 mile south of Jefferson, Oregon
(Approximate distance and direction from nearest city or town)

and is more particularly described as follows:

(a) N. 38° 20' E. 13.25 chains from SW corner of SE 1/4 Sec. 11, T. 10 S., R. 3 W.
(Give distance and bearing to corner of section or other legal subdivision)

being within SW 1/4 of SE 1/4 of Sec. 11, Twp. 10 S, Rge. 3 W
(Smallest legal subdivision) (N. or S.) (E. or W.)

or (b) within limits of recorded platted property, town or city:

in Lot _____, Block _____ of _____
(Name of plat or addition)

County of Linn
(If within city or town, give name)

3. Construction Work was begun on 1941; was completed on 1941
(Date) (Date)

and the ground water claimed was first used for the purposes set out below on 1941
(Date)

since which time the water has been used continuously
(Continuously or intermittently)

from 1941 to present time
(Date) (Date)

4. Quantity of water claimed and used is 220 gallons per minute; 27.5 acre feet per year.

5. Purpose or Purposes for which water is used Irrigation

(Domestic, irrigation, municipal, manufacturing, industrial, etc.)

6. Description of Well: Depth 30 feet. Type Driven
(Dug or drilled)

diameter 4 inches. Elevation of ground at well site 215 feet, mean sea level.
(As near as known)

Depth to water table 16 feet.

7. Capacity of Well: 300 g.p.m. with 4 feet drawdown.

_____ g.p.m. with _____ feet drawdown.


Date of test 1941

If Flowing Well: Measured discharge _____ g.p.m. on _____
(Date)

Shut-in pressure at ground surface _____ lbs. per sq. in. on _____
(Date)

Water is controlled by _____
(Cap, valve, etc.)

Township 10 S Range 3 W, W.M.
North

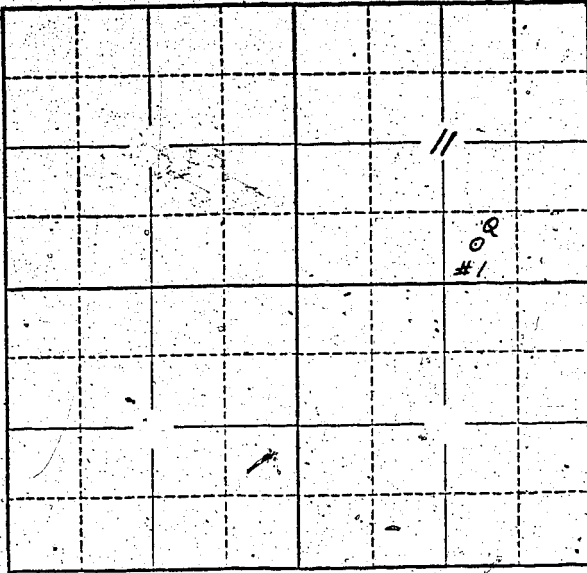

Locate well and acreage of irrigated land on plat.
(Scale: 2" = 1 Mile)

STATE OF OREGON

County of LINN

} ss.

I, John F. and Katie M. Grenz and George V. Grenz, being first duly sworn, do hereby certify that I have read the foregoing Registration Statement and that all of the items therein contained are true to the best of my knowledge and belief.

John F. Grenz Katie M. Grenz
(Signature of Registrant)

Subscribed and sworn to before me this 25th day of June, 1957.

My commission expires

MY COMMISSION EXPIRES JULY 25, 1960

(SEAL)

Edward C. Robinson
(Notary Public)

CERTIFICATE OF REGISTRATION

STATE OF OREGON

County of Marion

} ss.

This is to certify that the foregoing Registration Statement was received in the office of the State Engineer on the 30th day of June, 1958, at 8:00 o'clock A.M. and has been duly recorded in said office in Book No. B of Registration Statements on page GR-1802

Witness my hand this 26th day of January, 1959.

Laura A. Stanley
(State Engineer)

By

(Deputy)

\$15.00

GR - 1802