

RECEIVED  
JUN 30 1958  
STATE ENGINEER  
SALEM, OREGON

Registration No. GR - 1862  
Certificate No. GR - 1803

# Registration Statement

## OF CLAIMANT OF RIGHT TO APPROPRIATE GROUND WATER

TO THE STATE ENGINEER OF OREGON:

I, George C. and Mary M. Metcalf.

of Rt. 1, Box W 16, Lebanon County of Linn  
(Mailing address)

State of Oregon, do hereby make application for a certificate of registration as evidence of a right to appropriate ground water.

1. Source from which water is withdrawn is Pump well  
(Flowing well, pump well, infiltration trench, or tunnel)

2. Location is: SE edge of Waterloo, Oregon City Limits  
(Approximate distance and direction from nearest city or town)

and is more particularly described as follows:

(a) 310' S. and 188' E. of NW corner S. 33, T. 12 S, R. 1 W.W.M.  
(Give distance and bearing to corner of section or other legal subdivision)

being within NW 1/4 of NW 1/4 of Sec. 33, Twp. 12 S, Rge. 1 W  
(Smallest legal subdivision) (N. or S.) (E. or W.)

or (b) within limits of recorded platted property, town or city:

in Lot \_\_\_\_\_, Block \_\_\_\_\_ of \_\_\_\_\_  
(Name of plat or addition)

County of Linn  
(If within city or town, give name)

3. Construction Work was begun on 1950; was completed on 1950  
(Date) (Date)

and the ground water claimed was first used for the purposes set out below on July 1950  
(Date)

since which time the water has been used continuously  
(Continuously or Intermittently)

from July 1950 to present time  
(Date) (Date)

4. Quantity of water claimed and used is 17 gallons per minute; 9.0 acre feet per year.

5. Purpose or Purposes for which water is used Irrigation

(Domestic, irrigation, municipal, manufacturing, industrial, etc.)

6. Description of Well: Depth 19 feet. Type Driven  
(Dug or drilled)

diameter 2 inches. Elevation of ground at well site 370 feet, mean sea level.  
(As near as known)

Depth to water table 12 feet.

7. Capacity of Well: \_\_\_\_\_ g.p.m. with \_\_\_\_\_ feet drawdown.

\_\_\_\_\_ g.p.m. with \_\_\_\_\_ feet drawdown.

Date of test Not Tested

If Flowing Well: Measured discharge \_\_\_\_\_ g.p.m. on \_\_\_\_\_  
(Date)

Shut-in pressure at ground surface \_\_\_\_\_ lbs. per sq. in. on \_\_\_\_\_  
(Date)


Water is controlled by \_\_\_\_\_  
(Cap, valve, etc.)





Township 12 S Range 1 W, W.M.

North

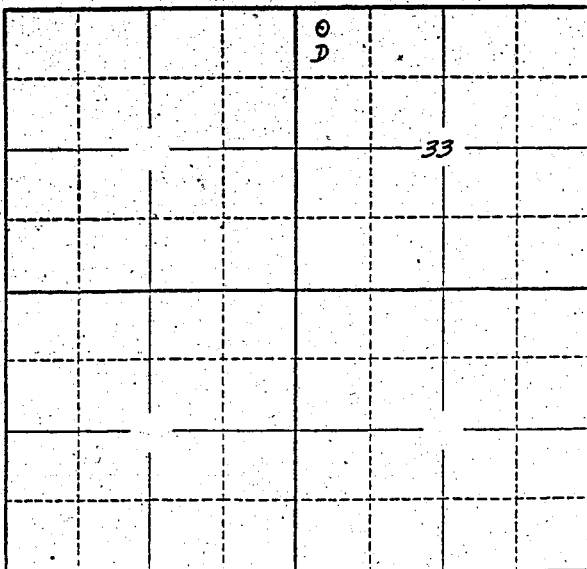

Locate well and acreage of irrigated land on plat:

Scale: 2" = 1 Mile

STATE OF OREGON

County of LINN

ss.

I, George C. and Mary M. Metcalf, being first duly sworn, do hereby certify that I have read the foregoing Registration Statement and that all of the items therein contained are true to the best of my knowledge and belief.

*George C. Metcalf*

*Mary M. Metcalf*  
(Signature of Registrant)

Subscribed and sworn to before me this 27 day of June, 1958

My commission expires

*Asks*  
(Notary Public)

(SEAL)

CERTIFICATE OF REGISTRATION

STATE OF OREGON

County of Marion

ss.

This is to certify that the foregoing Registration Statement was received in the office of the State Engineer on the 30th day of June, 1958, at 8:00 o'clock A.M. and has been duly recorded in said office in Book No. 8 of Registration Statements on page GR-1803

Witness my hand this 26th day of January, 1959

*Leura A. Stanley*  
(State Engineer)

By \_\_\_\_\_ (Deputy)

\$1500

GR - 1803