

RECEIVED
JUN 30 1958

STATE ENGINEER
SALEM, OREGON

Registration No. GR. 1865

Certificate No. GR. 1805

Registration Statement

OF CLAIMANT OF RIGHT TO APPROPRIATE GROUND WATER

TO THE STATE ENGINEER OF OREGON:

I, Herman Lindseth

of Route 3, Box 561, Corvallis

County of Benton

State of Oregon

, do hereby make application for a certificate of registration as evidence of a right to appropriate ground water.

1. Source from which water is withdrawn is pump well
(Flowing well, pump well, infiltration trench, or tunnel)

2. Location is: 10 miles south of Corvallis
(Approximate distance and direction from nearest city or town)

and is more particularly described as follows: 57' W hence 105' N to 1/4 section corner, Sec 25, 26,

(a) T. 13S, R. 5W, W.M. well
(Give distance and bearing to corner of section or other legal subdivision)

being within NW 1/4 SW 1/4 of Sec. 25, Twp. 13S, Rge. 5W
(Smallest legal subdivision) (N. or S.) (E. or W.)

or (b) within limits of recorded platted property, town or city:

in Lot _____, Block _____ of _____
(Name of plat or addition)

County of _____
(If within city or town, give name)

3. Construction Work was begun on 1952; was completed on 1952
(Date) (Date)

and the ground water claimed was first used for the purposes set out below on 1952
(Date)

since which time the water has been used continuously
(Continuously or intermittently)

from 1952 to 1958
(Date) (Date)

4. Quantity of water claimed and used is 25 when pumping gallons per minute; 7 1/2 acre feet per year.

5. Purpose or Purposes for which water is used irrigation, also for domestic & livestock water
(Domestic, irrigation, municipal, manufacturing, industrial, etc.)

6. Description of Well: Depth 28 feet. Type drilled
(Dug or drilled)
diameter 6 inches. Elevation of ground at well site 245 feet, mean sea level.
(As near as known)

Depth to water table 12 feet.

7. Capacity of Well: 30 g.p.m. with 1 feet drawdown.

2 g.p.m. with _____ feet drawdown.


Date of test 1952

If Flowing Well: Measured discharge _____ g.p.m. on _____
(Date)

Shut-in pressure at ground surface _____ lbs. per sq. in. on _____
(Date)

Water is controlled by _____
(Cap, valve, etc.)

Township 13 S Range 5 W, W.M.
North

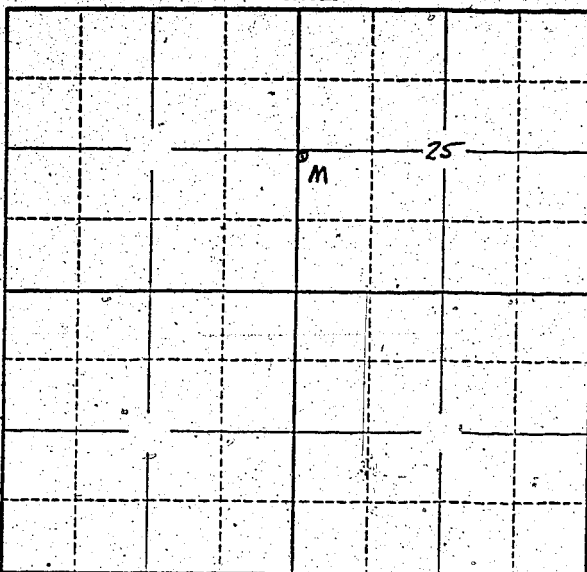

Locate well and acreage of irrigated land on plat.

Scale: 2" = 1 Mile

STATE OF OREGON

County of Benton } ss.

I, Herman Lindseth, being first duly sworn, do hereby certify that I have read the foregoing Registration Statement and that all of the items therein contained are true to the best of my knowledge and belief.

Herman Lindseth
(Signature of Registrant)

Subscribed and sworn to before me this 28th day of June, 1958

My commission expires October 17, 1960 Frank E. Wilson
(Notary Public)

(SEAL)

CERTIFICATE OF REGISTRATION

STATE OF OREGON } ss.
County of Marion

This is to certify that the foregoing Registration Statement was received in the office of the State Engineer on the 30th day of June, 1958, at 10⁰⁰ o'clock A. M. and has been duly recorded in said office in Book No. 8 of Registration Statements on page GR-1805

Witness my hand this 26th day of January

1959
Lewis A. Stanley
(State Engineer)

\$15.00

By _____ (Deputy)

GR - 1805