Registration No. GR-1821

Certificate No. GR-1811

Registration Statement

OF CLAIMANT OF RIGHT TO APPROPRIATE GROUND WATER

TO THE STATE ENGINEER OF OREGON:

I, Paul Knapp

of Rt 1 Box 129A Gervais Or (Mailing address) County of Marion

State of Oregon, do hereby make application for a certificate of registration as evidence of a right to appropriate ground water.

1. **Source** from which water is withdrawn is Pump Well #1 (Flowing well, pump well, infiltration trench, or tunnel)

2. **Location** is: 12 mi n.e. Salem on St. Paul Road to Elkridge school then 3rd house East. (Approximate distance and direction from nearest city or town)

and is more particularly described as follows: 1500 feet south & 210 feet east from NW corner Sect. 32

(a) Lots 30 and 31 in Edgewood (Give distance and bearing to corner of section or other legal subdivision)

being within SW¼ of NW¼ (Smallest legal subdivision) of Sec. 32, Twp. 5S (N. or S.), Rge. 2W (E. or W.)

or (b) within limits of recorded platted property, town or city:

in Lot ....., Block ....., of Edgewood (Name of plat or addition)

..... (If within city or town, give name) County of Marion

3. **Construction Work** was begun on June 10, 55 (Date); was completed on June 15 1955 (Date)

and the ground water claimed was first used for the purposes set out below on June 20 1955 (Date),

since which time the water has been used Intermittently (Continuously or intermittently)

from June (Date) to Sept Each year (Date).

4. **Quantity** of water claimed and used is 100 gallons per minute; ..... acre feet per year.

5. **Purpose or Purposes** for which water is used Pasture

..... (Domestic, irrigation, municipal, manufacturing, industrial, etc.)

6. **Description of Well:** Depth 106 feet. Type drilled (Dug or drilled)

diameter 6 inches. Elevation of ground at well site ..... (As near as known) feet, mean sea level.

Depth to water table 24 feet.

7. **Capacity of Well:** ..... g.p.m. with ..... feet drawdown.

..... g.p.m. with ..... feet drawdown.

Date of test .....

If Flowing Well: Measured discharge ..... g.p.m. on ..... (Date)

Shut-in pressure at ground surface ..... lbs. per sq. in. on ..... (Date)

Water is controlled by ..... (Cap, valve, etc.)

4M—4-57

8. **Casing:** (Give diameter, commercial specifications and depth below ground surface of each casing size.)

6 inch diameter steel casing from 0 to 10.6 feet

..... inch diameter ..... from ..... to ..... feet

..... inch diameter ..... from ..... to ..... feet

..... inch diameter ..... from ..... to ..... feet

Describe and show depth of shoe, plug, adapter, liner or other details: .....

9. **Perforated Casings or Screens:**

None

(Number per foot and size of perforations, or describe screen) from ..... to .....

..... from ..... to .....

..... from ..... to .....

..... from ..... to .....

10. **Log of Well:** (Describe each stratum or formation clearly, indicate if water bearing, and give thickness and depth as indicated.)

MATERIAL	Thickness (Feet)	Depth to Bottom (Feet)
gravel + sands		

GR 1811

If log of well is not available, give name and address of driller: Wymore

11. **Infiltration Trench:** Covered or open .....

Dimensions: Length ..... ft. Minimum depth ..... ft. Maximum depth ..... ft.

Bottom width ..... ft. Discharge ..... g.p.m. Date of test .....

12. **Tunnel:** Type of lining .....

Dimensions: .....
(Length, course, and cross sectional size)

Position of water bearing stratum with reference to portal of tunnel .....

Log of tunnel: (Preceding table for log of well may be used, if desired. Give footage from portal and character of materials, as pertinent.)

13. **Pumping Equipment:**

(a) Pump Fairbanks Morse Jet (Make, type and size) Capacity 100 g.p.m.

(b) Motor 1½ H.P. ? (Type and horsepower)

14. Location of area irrigated or to be irrigated, or place of use if for purposes other than irrigation.

Township North or South	Range E. or W. of Willamette Meridian	Section	Forty-acre Tract	Number Acres To Be Irrigated	Date of Reclamation
T 5 S	R 2 W	32	NW¼ of NW¼	6 ±	6-20-55
"	"	"	SW¼ of NW¼	4 ±	"
				10 ± Ac	"

15. If the ground water supply is supplemental to an existing water supply, identification of any application for a permit, permit, certificate or adjudicated right to appropriate water made or held by the registrant.

.....

.....

Township 1S Range 2W W.M.

North

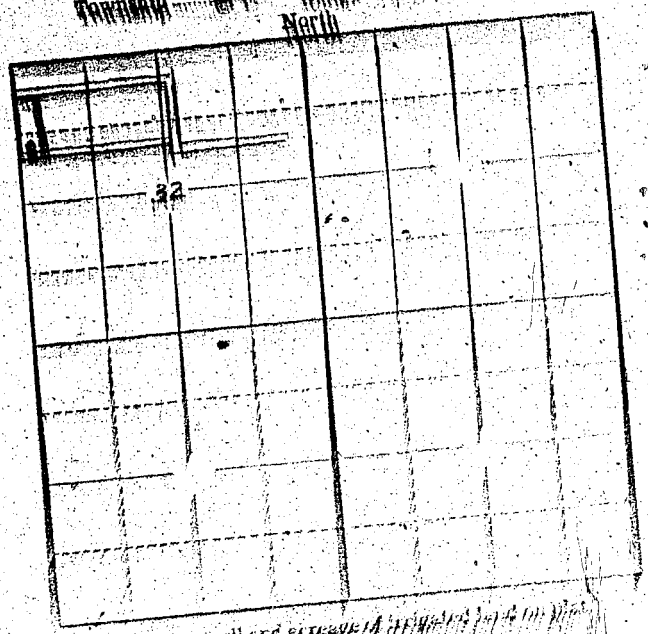

[illegible]

STATE OF OREGON

County of Marion

[illegible]

[illegible]

[illegible]

[illegible] 13th June 1961

(SEAL)

[illegible]

STATE OF OREGON

County of [illegible]

[illegible]