

Registration Statement

OF CLAIMANTS OF RIGHT TO APPROPRIATE GROUND WATER

TO THE STATE ENGINEER OF OREGON:

I, Paul Krapp
of Rt. 1 Box 129A Gervais County of Marrion
(Mailing address)

State of Oregon, do hereby make application for a certificate of registration as evidence of a right to appropriate ground water.

1. Source from which water is withdrawn is Pump Well #2
(Flowing well, pump well, infiltration trench, or tunnel)

2. Location is: 3 mi SW of Gervais
(Approximate distance and direction from nearest city or town)

and is more particularly described as follows: 1420 feet north & 1640 feet east from SW corner 33

(a) in the N.W. corner at Baldach Friday & Concordia Rd.
(Give distance and bearing to corner of section or other legal subdivision)

being within NE 1/4 of SW 1/4 of Sec. 33, Twp. 5 South Rge. 2 West
(Smallest legal subdivision) (E or S.) (E or W.)

or (b) within limits of recorded platted property, town or city:

in Lot _____, Block _____ of _____
(Name of plat or addition)

County of _____
(If within city or town, give name)

3. Construction Work was begun on June 49; was completed on June 49
(Date) (Date)

and the ground water claimed was first used for the purposes set out below on July 1949
(Date)

since which time the water has been used Intermittently until 1956 then continuously
(Continuously or intermittently)

from July 1 to Sept 1
(Date) (Date)

4. Quantity of water claimed and used is 200 60 gallons per minute; 17 acre feet per year.

5. Purpose or Purposes for which water is used Irrigation for pasture
(Domestic, irrigation, municipal, manufacturing, industrial, etc.)

6. Description of Well: Depth 65 feet. Type drilled
(Dug or drilled)

diameter 12 inches. Elevation of ground at well site _____ feet, mean sea level.
(As near as known)

Depth to water table 24 feet.

7. Capacity of Well: 200 g.p.m. with 40 feet drawdown.

_____ g.p.m. with _____ feet drawdown.


Date of test _____

If Flowing Well: Measured discharge _____ g.p.m. on _____
(Date)

Shut-in pressure at ground surface _____ lbs. per sq. in. on _____
(Date)

Water is controlled by _____
(Cap. valve, etc.)

Township 55 Range 2W, W.M.
North

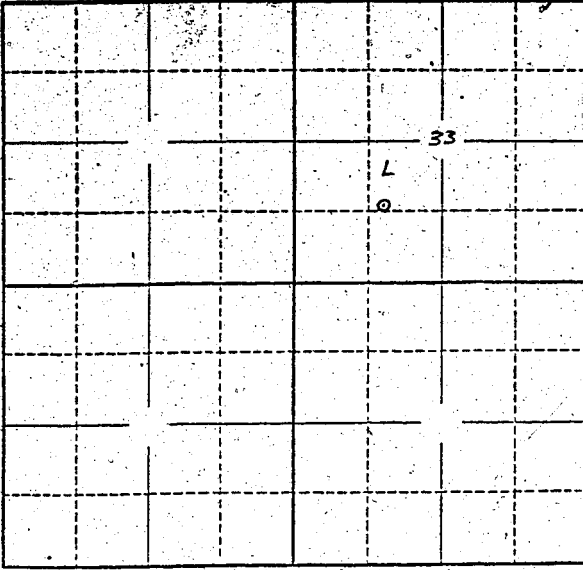

Locate well and acreage of irrigated land on plat.
Scale: 2" = 1 Mile

STATE OF OREGON }
County of Marion } ss.

I, _____, being first duly sworn, do hereby certify that I have read the foregoing Registration Statement and that all of the items therein contained are true to the best of my knowledge and belief.

Paul Krapp
(Signature of Registrant)

Subscribed and sworn to before me this 30th day of June, 1958

My commission expires 12th June 1961 Wm. S. Bartholomew
(Notary Public)

(SEAL)

CERTIFICATE OF REGISTRATION

STATE OF OREGON }
County of Marion } ss.

This is to certify that the foregoing Registration Statement was received in the office of the State Engineer on the 30th day of June, 1958, at 2:30 o'clock P. M. and has been duly recorded in said office in Book No. 18 of Registration Statements on page GR-1812

Witness my hand this 26th day of January, 1959

Lewis A. Pittinsky
(State Engineer)

By _____
(Deputy)

\$ 15.00

GR - 1812