

OF CLAIMANT OF RIGHT TO APPROPRIATE GROUND WATER

(Under Chapter 708, Oregon Laws 1955.)

TO THE STATE ENGINEER OF OREGON:

I, Kenneth H. Dalton

of Independence County of Polk

State of Oregon, do hereby make application for a certificate of registration as evidence of a right to appropriate ground water.

1. Source from which water is withdrawn is Pump Well #1
(Flowing well, pump well, infiltration trench, or tunnel)

2. Location is: at Southwest City Limits- Independence- Oregon
(Approximate distance and direction from nearest city or town)

and is more particularly described as follows: (890 feet east of 400 feet south from Center of section 29.)

(a) 650 ft. W & 270 ft. S. of NW Cor. of Block 7 in White's Addition
(Give distance and bearing to corner of section or other legal subdivision)

being within NW 1/4 of SE 1/4 of Sec. 29, Twp. 8 S Rge. 4 W
(Smallest legal subdivision) (N. or S.) (E. or W.)

or (b) within limits of recorded platted property, town or city: Independence

in Lot 8 Acres, Block 7 of White's Addition
(Name of plat or addition)

(If within city or town, give name) County of Polk

3. Construction Work was begun on July 22, 1952; was completed on July 25, 1952
(Date) (Date)

and the ground water claimed was first used for the purposes set out below on July 27, 1952
(Date)

since which time the water has been used intermittently
(Continuously or intermittently)

from April to October
(Date) (Date)

4. Quantity of water claimed and used is 80 to 150 gallons per minute; 44.5 acre feet per year.

5. Purpose or Purposes for which water is used irrigation

(Domestic, irrigation, municipal, manufacturing, industrial, etc.)

6. Description of Well: Depth 65 feet. Type Drilled

(Dug or drilled)

diameter 8 inches. Elevation of ground at well site Approx 1700 feet, mean sea level.
(As near as known)

Depth to water table 27 feet.

7. Capacity of Well: 80 to 150 g.p.m. with ? feet drawdown.

? g.p.m. with ? feet drawdown.


Date of test July 25, 1952

If Flowing Well: Measured discharge ? g.p.m. on ?
(Date)

Shut-in pressure at ground surface ? lbs. per sq. in. on ?
(Date)

Water is controlled by ?
(Cap, valve, etc.)

Township 8S Range 4W, W.M.
North

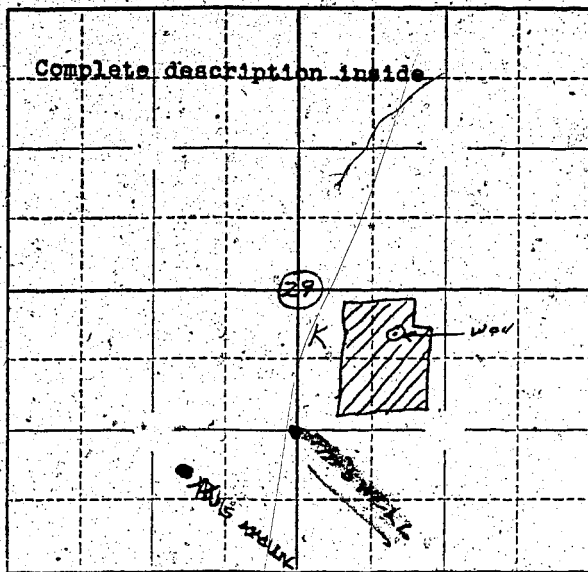

Locate well and acreage of irrigated land on plat.

Scale: 8" = 1 Mile

4" =

STATE OF OREGON

County of Polk

ss.

I, Kenneth H. Dalton, being first duly sworn, do hereby certify that I have read the foregoing Registration Statement and that all of the items therein contained are true to the best of my knowledge and belief.

Kenneth Dalton
(Signature of Registrant)

Subscribed and sworn to before me this 15th day of August, 1957.

My commission expires Sept. 10, 1960

Eustace Cook
(Notary Public)

(SEAL)

CERTIFICATE OF REGISTRATION

STATE OF OREGON

County of Marion

ss.

This is to certify that the foregoing Registration Statement was received in the office of the State Engineer on the 15th day of July, 1958, at 5:00 o'clock A.M. and has been duly recorded in said office in Book No. 8 of Registration Statements on page GR-1814

~~Construction has been completed by _____ and the same is hereby reported as~~
~~completed by _____~~

Witness my hand this 26th day of January, 1959

Lawrence A. Stanley
(State Engineer)

#1500

By

(Deputy)

GR-1814