

RECEIVED
STATE ENGINEER
SALEM, OREGON

Registration No. GR-1876

Certificate No. GR-1815

Registration Statement

OF CLAIMANT OF RIGHT TO APPROPRIATE GROUND WATER

TO THE STATE ENGINEER OF OREGON:

I, Rex Ray Gildow
of Box #1 Box 252 Independence County of Polk
(Mailing address)

State of Oregon, do hereby make application for a certificate of registration as evidence of a right to appropriate ground water.

- Source from which water is withdrawn is Pump well
(Flowing well, pump well, infiltration trench, or tunnel)
- Location is: 1 mi. N. of Independence
(Approximate distance and direction from nearest city or town)

and is more particularly described as follows:

(a) Well located 266' south + 4325' East from N.W. corner of
SE 4 of the SW 1/4 (Give distance and bearing to corner of section or other legal subdivision)
being within Thomas Burbank D.L.C. #3 of Sec. 16, Twp. 25, Rge. 4 W
(Smallest legal subdivision) (N. or S.) (E. or W.)

or (b) within limits of recorded platted property, town or city:
in Lot _____, Block _____ of _____
(Name of plat or addition)

County of _____
(If within city or town, give name)

3. Construction Work was begun on May 1954, was completed on June 1954
(Date) (Date)

and the ground water claimed was first used for the purposes set out below on June 1954
(Date)

since which time the water has been used Household - Continuously - Summer - intermittent
(Continuously or intermittently)

from June 1954 to June 1958
(Date) (Date)

4. Quantity of water claimed and used is 20 gallons per minute; _____ acre feet per year.

5. Purpose or Purposes for which water is used Household - Irrigation

(Domestic, irrigation, municipal, manufacturing, industrial, etc.)

6. Description of Well: Depth 57 feet. Type Drilled
(Dug or drilled)

diameter 8 inches. Elevation of ground at well site 190' feet, mean sea level.
(As near as known)

Depth to water table 25 feet.

7. Capacity of Well: 30 g.p.m. with 4 feet drawdown.

_____ g.p.m. with _____ feet drawdown.

Date of test with 2 hp. Irrigation pump. June 1954

If Flowing Well: Measured discharge _____ g.p.m. on _____
(Date)

Shut-in pressure at ground surface _____ lbs. per sq. in. on _____
(Date)

Water is controlled by _____
(Cap, valve, etc.)

8. Casing: (Give diameter, commercial specifications and depth below ground surface of each casing size.)

8" inch diameter Steel from 0 to 57' feet
 _____ inch diameter _____ from _____ to _____ feet
 _____ inch diameter _____ from _____ to _____ feet
 _____ inch diameter _____ from _____ to _____ feet

Describe and show depth of shoe, plug, adapter, liner or other details: _____

9. Perforated Casings or Screens:

Perforated from 47' to 57'
(Number per foot and size of perforations, or describe screen)
 _____ from _____ to _____
 _____ from _____ to _____
 _____ from _____ to _____

10. Log of Well: (Describe each stratum or formation clearly, indicate if water bearing, and give thickness and depth as indicated.)

MATERIAL	Thickness (Feet)	Depth to Bottom (Feet)
clay	20	
sand	5	
Gravel	30	
clay	2	

If log of well is not available, give name and address of driller.

11. Infiltration Trench: Covered or open

Dimensions: Length _____ ft. Minimum depth _____ ft. Maximum depth _____ ft.

Bottom width _____ ft. Discharge _____ g.p.m. Date of test _____

12. Tunnel: Type of lining

Dimensions: _____
(Length, course, and cross sectional size)

Position of water bearing stratum with reference to portal of tunnel _____

Log of tunnel: (Preceding table for log of well may be used, if desired. Give footage from portal and character of materials, as pertinent.)

13. Pumping Equipment:

(a) Pump Tecuzzi Jet Capacity 20 g.p.m.
(Make, type and size)


(b) Motor Tecuzzi - 2hp.
(Type and horsepower)

14. Location of area irrigated or to be irrigated, or place of use if for purposes other than irrigation.

Township North or South	Range E. or W. of Willamette Meridian	Section	Forty-acre Tract	Number Acres To Be Irrigated	Date of Reclamation
8 S	4 W	16	SE $\frac{1}{4}$ -SW $\frac{1}{4}$	6.2	1957

15. If the ground water supply is supplemental to an existing water supply, identification of any application for a permit, permit, certificate or adjudicated right to appropriate water made or held by the registrant.

Township 8 S Range 4 W, W.M.
North

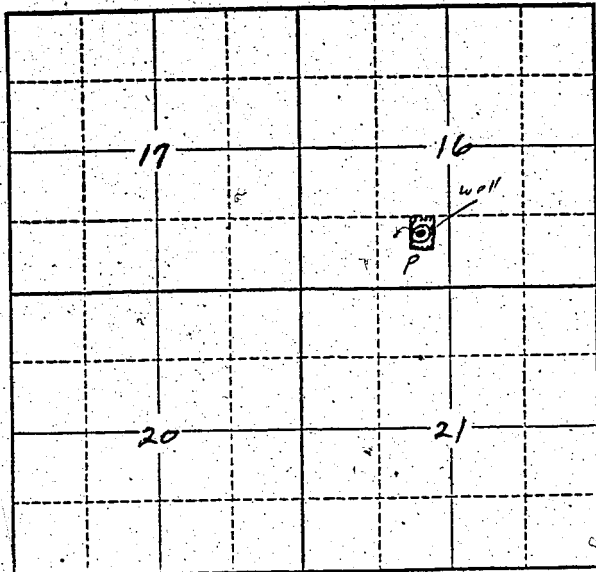

Locate well and acreage of irrigated land on plat.
Scale: 2" = 1 Mile

STATE OF OREGON }
County of Polk } ss.

I, Russell Guy SANDERLIN, being first duly sworn, do hereby certify that I have read the foregoing Registration Statement and that all of the items therein contained are true to the best of my knowledge and belief.

Russell Guy Sanderlin
(Signature of Registrant)

Subscribed and sworn to before me this 30 day of JUNE, 1958

My commission expires August 11, 1960
James G. [Signature]
(Notary Public)

(SEAL)

CERTIFICATE OF REGISTRATION

STATE OF OREGON }
County of Marion } ss.

This is to certify that the foregoing Registration Statement was received in the office of the State Engineer on the 1st day of July, 1958, at 3:00 o'clock A.M. and has been duly recorded in said office in Book No. 8 of Registration Statements on page GR-1815

Witness my hand this 26th day of January, 1959

Lewis A. Stanley
(State Engineer)

\$ 15.00

By _____ (Deputy)

GR 1815