

Registration Statement

OF CLAIMANT OF RIGHT TO APPROPRIATE GROUND WATER

TO THE STATE ENGINEER OF OREGON:

I, S. H. Rothstrom
of Rt. 2, Box 52, Hillsboro, County of Washington
Oregon (Mailing address)

State of _____ do hereby make application for a certificate of registration as evidence of a right to appropriate ground water.

- 1. Source from which water is withdrawn is Pump well
(Flowing well, pump well, infiltration trench, or tunnel)
- 2. Location is: Six miles South of Hillsboro, Ore.
(Approximate distance and direction from nearest city or town)

and is more particularly described as follows:

(a) 176 yards South, 60 yards East from NW corner of Sec. 6
(Give distance and bearing to corner of section or other legal subdivision)
being within NW 1/4 NW 1/4 of Sec. 6, Twp. 2S, Rge. 2W
(Smallest legal subdivision) (N. or S.) (E. or W.)

or (b) within limits of recorded platted property, town or city:
in Lot _____, Block _____ of _____
(Name of plat or addition)

County of _____
(If within city or town, give name)

- 3. Construction Work was begun on Oct. 13, 1947; was completed on Nov. 24, 1947
(Date) (Date)

and the ground water claimed was first used for the purposes set out below on NOV. 25, 1947
(Date)
since which time the water has been used Continuously
(Continuously or intermittently)

from NOV. 25, 1947 to June 27, 1958
(Date) (Date)

- 4. Quantity of water claimed and used is 128 gallons per minute; 75 acre-feet per year.

- 5. Purpose or Purposes for which water is used Irrigation
(Domestic, irrigation, municipal, manufacturing, industrial, etc.)

6. Description of Well: Depth 486 feet. Type Drilled
(Dug or drilled)
diameter six inches. Elevation of ground at well site 160' feet, mean sea level.
(As near as known)
Depth to water table 14 feet.


- 7. Capacity of Well: 128 g.p.m. with 18 feet drawdown.
_____ g.p.m. with _____ feet drawdown.
Date of test not tested

If Flowing Well: Measured discharge _____ g.p.m. on _____
(Date)

Shut-in pressure at ground surface _____ lbs. per sq. in. on _____
(Date)

Water is controlled by _____
(Cap, valve, etc.)

Township 2S Range 2W W.M.
North

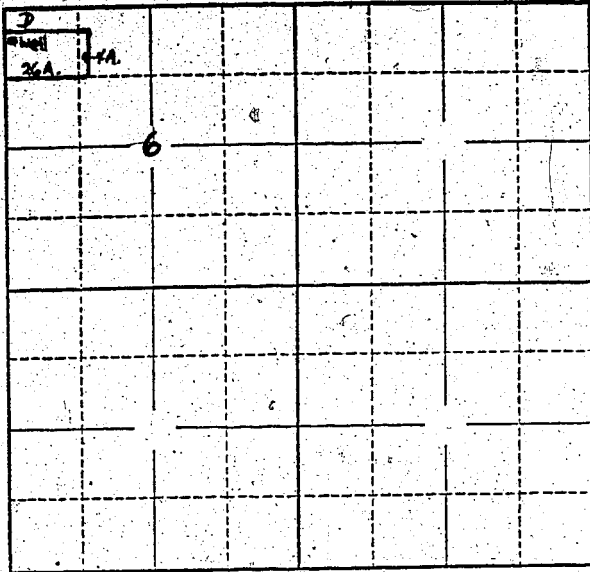

Locate well and acreage of irrigated land on plat.
Scale: 2" = 1 Mile

STATE OF OREGON

County of Washington } ss.

I, S. H. ROTHSTROM, being first duly sworn, do hereby certify that I have read the foregoing Registration Statement and that all of the items therein contained are true to the best of my knowledge and belief.

S. H. Rothstrom
(Signature of Registrant)

Subscribed and sworn to before me this 27 day of June, 1958

My commission expires Dec 4, 1959

J. H. Anderson
(Notary Public)

(SEAL)

CERTIFICATE OF REGISTRATION

STATE OF OREGON

County of Marion } ss.

This is to certify that the foregoing Registration Statement was received in the office of the State Engineer on the 1st day of July, 1958, at 9:00 o'clock A. M. and has been duly recorded in said office in Book No. 8 of Registration Statements on page GR-1816

Witness my hand this 26th day of January, 1959

Lewis A. Stanley
(State Engineer)

#15.00

By _____ (Deputy)