

Registration Statement

OF CLAIMANT OF RIGHT TO APPROPRIATE GROUND WATER

TO THE STATE ENGINEER OF OREGON:

I, Theodore F. Welty

of 12616 S. W. 65th St., Portland 19, Ore. County of Multnomah

State of Oregon, do hereby make application for a certificate of registration as evidence of a right to appropriate ground water.

1. Source from which water is withdrawn is Pump well for irrigation
(Flowing well, pump well, infiltration trench, or tunnel)

2. Location is: 3 1/2 miles west of Canby on Butteville road
(Approximate distance and direction from nearest city or town)

and is more particularly described as follows:

(a) 2640 feet West and 3450 feet South and ~~25~~ feet West from the Northeast corner of Section 3, T. 4 S., R. 1 W., W.M.
(Give distance and bearing to corner of section or other legal subdivision)

being within N.W. 1/4 of S. 1/4 of Sec. 3, Twp. 4 S., Rge. 1 W. W.M.
(Smallest legal subdivision) (N. or S.) (E. or W.)

or (b) within limits of recorded platted property, town or city:

in Lot _____, Block _____ of _____
(Name of plat or addition)

County of Marian
(If within city or town, give name)

3. Construction Work was begun on 1951; was completed on 1951
(Date) (Date)

and the ground water claimed was first used for the purposes set out below on 1951
(Date)

since which time the water has been used continuously
(Continuously or Intermittently)

from 1951 to Oct. 1957
(Date) (Date)

4. Quantity of water claimed and used is 300 + 360 gallons per minute; _____ acre feet per year.

5. Purpose or Purposes for which water is used irrigation

(Domestic, irrigation, municipal, manufacturing, industrial, etc.)

6. Description of Well: Depth 149 feet. Type drilled
(Dug or drilled)

diameter 8 inches. Elevation of ground at well site approx. 200 feet, mean sea level.
(AS near as known)

Depth to water table unknown feet. 1951

7. Capacity of Well: 350+ g.p.m. with 40 feet drawdown. after 2 hrs.

_____ g.p.m. with _____ feet drawdown.

Date of test 1951

If Flowing Well: Measured discharge _____ g.p.m. on _____
(Date)

Shut-in pressure at ground surface _____ lbs. per sq. in. on _____
(Date)

Water is controlled by _____
(Cap, valve, etc.)

If log of well is not available, give name and address of driller. Sneed & Sons

11. Infiltration Trench: Covered or open _____
 Dimensions: Length _____ ft. Minimum depth _____ ft. Maximum depth _____ ft.
 Bottom width _____ ft. Discharge _____ g.p.m. Date of test _____

12. Tunnel: Type of lining _____
 Dimensions: _____
(Length, course, and cross sectional size)
 Position of water bearing stratum with reference to portal of tunnel _____

Log of tunnel: (Preceding table for log of well may be used, if desired. Give footage from portal and character of materials, as pertinent.)

13. Pumping Equipment:
 (a) Pump Berkley pump - Turbine Capacity 350 g.p.m.
(Make, type and size)
 (b) Motor 25 H.P. electric 3 phase
(Type and horsepower)


14. Location of area irrigated or to be irrigated, or place of use if for purposes other than irrigation.

Township North or South	Range E. or W. of Willamette Meridian	Section	Forty-acre Tract	Number Acres To Be Irrigated	Date of Reclamation
					1951
		Whole property See attached plat			
T4S	R1W	3	NW ¹ / ₄ of NE ¹ / ₄	11. ⁰	"
"	"	3	SW ¹ / ₄ of NE ¹ / ₄	11. ⁰	"
"	"	"	SE ¹ / ₄ of NW ¹ / ₄	10. ⁰	"
"	"	"	NE ¹ / ₄ of SW ¹ / ₄	39. ⁰	"
"	"	"	SE ¹ / ₄ of SW ¹ / ₄	21. ⁰	"
"	"	"	NW ¹ / ₄ of SE ¹ / ₄	6. ⁰	"
"	"	10	NE ¹ / ₄ of NW ¹ / ₄	2. ⁰	"
				<u>100.0</u>	"

15. If the ground water supply is supplemental to an existing water supply, identification of any application for a permit, permit, certificate or adjudicated right to appropriate water made or held by the registrant.

Domestic well put in same year _____

Township 43 Range 1W W.M.
North

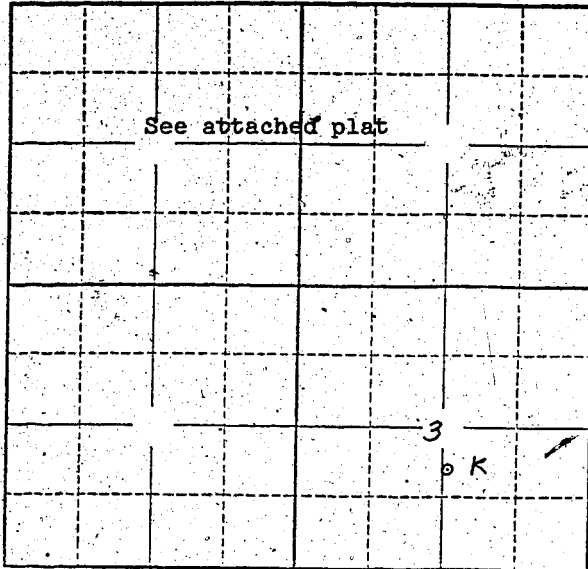

Locate well and acreage of irrigated land on plat.
Scale: 2" = 1 Mile

STATE OF OREGON

County of Marion } ss.

I, Theodore F. Welty, being first duly sworn, do hereby certify that I have read the foregoing Registration Statement and that all of the items therein contained are true to the best of my knowledge and belief.

Theodore F. Welty
(Signature of Registrant)

Subscribed and sworn to before me this 1 day of July, 1958.

My commission expires Oct. 16, 1959

Merle H. Johnson
(Notary Public)

(SEAL)

CERTIFICATE OF REGISTRATION

STATE OF OREGON

County of Marion } ss.

This is to certify that the foregoing Registration Statement was received in the office of the State Engineer on the 1st day of July, 1958, at 12⁰⁰ o'clock A.M. and has been duly recorded in said office in Book No. 8 of Registration Statements on page GR-1817

Witness my hand this 26th day of January, 1959.

Lawrence A. Standley
(State Engineer)

\$ 25.50

By _____ (Deputy)

GR-1817