

Registration No. GR - 1879

Certificate No. GR - 1818

Registration Statement

OF CLAIMANT OF RIGHT TO APPROPRIATE GROUND WATER

TO THE STATE ENGINEER OF OREGON:

I, James Hasvike

of 15265 SW Bend Rd. Tigard, Oregon County of WASHINGTON

State of OREGON, do hereby make application for a certificate of registration as evidence of a right to appropriate ground water.

1. Source from which water is withdrawn is PUMP WELL
(Flowing well, pump well, infiltration trench, or tunnel)

2. Location is: 5 MILE SW of TIGARD
(Approximate distance and direction from nearest city or town)

and is more particularly described as follows: Section 430 feet west of 350 feet south from NE Corner Sect 19.

(Give distance and bearing to corner of section or other legal subdivision)

being within NE 1/4 of NE 1/4 of Sec. 1973, Twp. 2 S, Rge. 1 N
(Smallest legal subdivision) (N. or S.) (E. or W.)

or (b) within limits of recorded platted property, town or city: _____

in Lot _____, Block _____ of _____
(Name of plat or addition)

County of _____
(If within city or town, give name)

3. Construction Work was begun on Prior to 1952; was completed on 1952
(Date) (Date)

and the ground water claimed was first used for the purposes set out below on 1952
(Date)

since which time the water has been used _____
(Continuously or intermittently)

from 1952 to Oct 1957
(Date) (Date)

4. Quantity of water claimed and used is 150 gallons per minute; 20 acre feet per year.

5. Purpose or Purposes for which water is used F.I.M. Irrigation

(Domestic, irrigation, municipal, manufacturing, industrial, etc.)

6. Description of Well: Depth 173 feet. Type Drilled
(Dug or drilled)

diameter 10" inches. Elevation of ground at well site 95 feet, mean sea level.
(As near as known)

Depth to water table 170 feet.

7. Capacity of Well: 175 g.p.m. with 15 feet drawdown.

_____ g.p.m. with _____ feet drawdown.


Date of test 8-52

If Flowing Well: Measured discharge _____ g.p.m. on _____
(Date)

Shut-in pressure at ground surface _____ lbs. per sq. in. on _____
(Date)

Water is controlled by _____
(Cap, valve, etc.)

Township 25 Range 1 N, W.M.
North

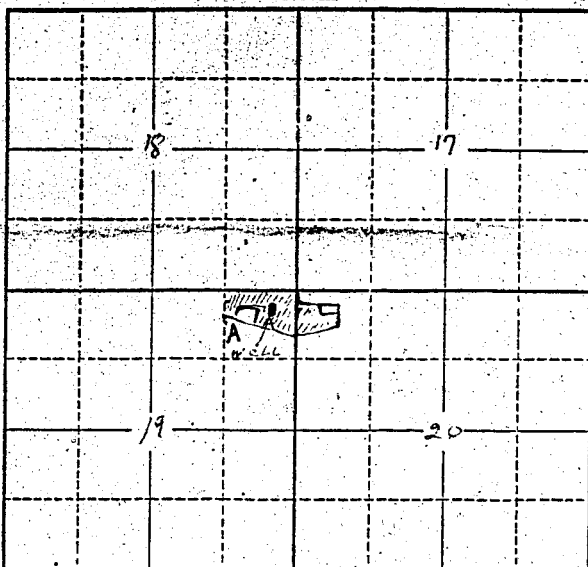

Locate well and acreage of irrigated land on plat.
Scale: 2" = 1 Mile

STATE OF OREGON

County of Washington } ss.

I, James Hasuika, being first duly sworn, do hereby certify that I have read the foregoing Registration Statement and that all of the items therein contained are true to the best of my knowledge and belief.

James Hasuika
(Signature of Registrant)

Subscribed and sworn to before me this 29th day of May, 19 58

My commission expires August 18, 1960

W. Vincent
(Notary Public)

(SEAL)

CERTIFICATE OF REGISTRATION

STATE OF OREGON

County of Marion } ss.

This is to certify that the foregoing Registration Statement was received in the office of the State Engineer on the 2nd day of July, 19 58, at 8:00 o'clock A M. and has been duly recorded in said office in Book No. 8 of Registration Statements on page GR-1818

Witness my hand this 26th day of January, 19 59

Levia A. Stanley
(State Engineer)

By _____
(Deputy)

GR - 1818

\$15.00