

RECEIVED
MAY 22 1956
STATE ENGINEER
SALEM, OREGON

Registration Statement

REGISTRATION NO. GR-188
CERTIFICATE NO. GR-174

OF CLAIMANT OF RIGHT TO APPROPRIATE GROUND WATER

(Under Chapter 708, Oregon Laws 1955.)

TO THE STATE ENGINEER OF OREGON:

I, Charles Capples of the Eugene Country Club

of Eugene County of Lane

State of Oregon, do hereby make application for a certificate of registration as evidence of a right to appropriate ground water.

1. Source from which water is withdrawn is Pump Well

(Flowing well, pump well, infiltration trench, or tunnel)

2. Location is: one and one half mile north by northeast of Eugene, Ore;

(Approximate distance and direction from nearest city or town)

and is more particularly described as follows:

(a) South 69° 49' East 1985 feet to Southeast corner Charles W. Young DLC No. 53 T 17 S R 3W

(Give distance and bearing to corner of section or other legal subdivision)

being within NW 1/4 of NW 1/4 of Sec. 29, Twp. 17 S, Rge. 3 W

(Smallest legal subdivision)

(N. or S.)

(E. or W.)

or (b) within limits of recorded platted property, town or city:

in Lot _____, Block _____ of _____

(Name of plat or addition)

County of Lane

(If within city or town, give name)

3. Construction Work was begun on May, 1953; was completed on June, 1953

(Date)

(Date)

and the ground water claimed was first used for the purposes set out below on June 1, 1953

(Date)

since which time the water has been used intermittently

(Continuously or Intermittently)

from April to October

(Date)

(Date)

4. Quantity of water claimed and used is 1000 gallons per minute; 119.30 acre feet per year.

5. Purpose or Purposes for which water is used irrigation

(Domestic, irrigation, municipal, manufacturing, industrial, etc.)

6. Description of Well: Depth 65 feet. Type drilled

(Dug or drilled)

diameter 14 inches. Elevation of ground at well site 416.0 feet, mean sea level.

(As near as known)

Depth to water table 6 to 10 feet.

7. Capacity of Well: 1000 g.p.m. with 10 feet drawdown.

_____ g.p.m. with _____ feet drawdown.

Date of test August 7, 1953

If Flowing Well: Measured discharge _____ g.p.m. on _____

(Date)


Shut-in pressure at ground surface _____ lbs. per sq. in. on _____

(Date)

Water is controlled by _____

(Cap, valve, etc.)

Township 17 S Range 3 W W.M.
North

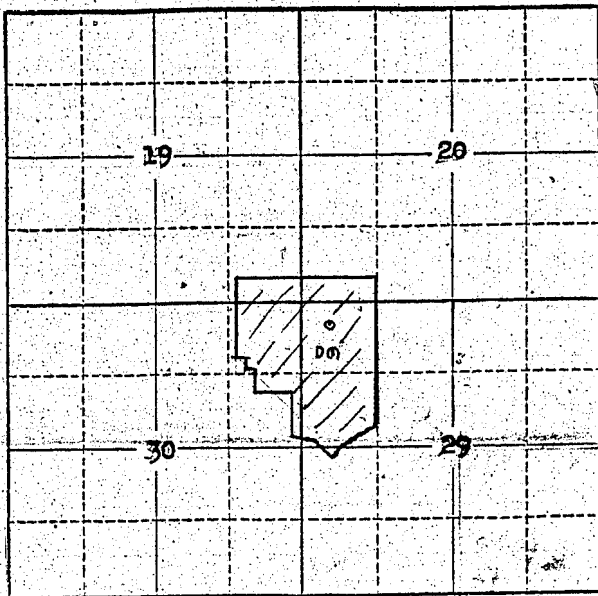

Locate well and acreage of irrigated land on plat.
Scale: 2" = 1 Mile

STATE OF OREGON

County of HANE } ss.

I, CHARLES CAPPLE being first duly sworn, do hereby certify that I have read the foregoing Registration Statement and that all of the items therein contained are true to the best of my knowledge and belief.

[Signature]
.....
(Signature of Registrant)

Subscribed and sworn to before me this day of, 19.....

My commission expires 1/13/58

[Signature]
.....
(Notary Public)

(SEAL)

CERTIFICATE OF REGISTRATION

STATE OF OREGON

County of Marion } ss.

This is to certify that the foregoing Registration Statement was received in the office of the State Engineer on the 22nd day of May, 1956, at 8 o'clock A. M. and has been duly recorded in said office in Book No. 1 of Registration Statements on page GR-174 C

~~.....~~
~~.....~~

Witness my hand this 8th day of October, 1956

[Signature]
.....
(State Engineer)

By
(Deputy)

GR-174 C