

STATE ENGINEER
SALES DIVISION

Registration Statement

OF CLAIMANT OF RIGHT TO APPROPRIATE GROUND WATER

TO THE STATE ENGINEER OF OREGON:

I, M. O. Salmon and Morse Bros.

of 535 W. 11th Ave., Albany
(Mailing address)

County of Linn

State of Oregon

, do hereby make application for a certificate of registration as evidence of a right to appropriate ground water.

1. Source from which water is withdrawn is Pump well

(Flowing well, pump well, infiltration trench, or tunnel)

2. Location is: 1 1/2 miles East of Albany, Oregon

(Approximate distance and direction from nearest city or town)

and is more particularly described as follows:

(a) S. 46° 22' E. 49.75 chains from the SE corner DLC 40

(Give distance and bearing to corner of section or other legal subdivision)

being within ~~1/4~~ of ~~1/4~~ NE 1/4 + NE 1/4 of Sec. 10, Twp. 11 S, Rge. 3 W

(Smallest legal subdivision)

(N. or S.)

(E. or W.)

or (b) within limits of recorded platted property, town or city:

in Lot _____, Block _____ of _____

(Name of plat or addition)

County of Linn

(If within city or town, give name)

3. Construction Work was begun on April 20, 1955

(Date)

; was completed on May 28, 1955

(Date)

and the ground water claimed was first used for the purposes set out below on June 1, 1955

(Date)

since which time the water has been used continuously

(Continuously or intermittently)

from June 1, 1955 to present time

(Date)

(Date)

4. Quantity of water claimed and used is (400*) 300 gallons per minute; 118 acre feet per year.

5. Purpose or Purposes for which water is used washing gravel

(Domestic, irrigation, municipal, manufacturing, industrial, etc.)

6. Description of Well: Depth 149 feet. Type drilled

(Dug or drilled)

diameter 8 inches. Elevation of ground at well site 235 feet, mean sea level.

(As near as known)

Depth to water table 12 feet.

7. Capacity of Well: 300 g.p.m. with 45 feet drawdown.

_____ g.p.m. with _____ feet drawdown.

Date of test Not tested - estimated

If Flowing Well: Measured discharge _____ g.p.m. on _____

(Date)

Shut-in pressure at ground surface _____ lbs. per sq. in. on _____

(Date)

Water is controlled by _____

(Cap, valve, etc.)

* 400 gallons per minute used out of a cistern for 8 hours. Cistern filled from well during 11 hour period.

8. Casing: (Give diameter, commercial specifications and depth below ground surface of each casing size.)

8 inch diameter steel casing from 0 to 119 feet
inch diameter from to feet
inch diameter from to feet
inch diameter from to feet

Describe and show depth of shoe, plug, adapter, liner or other details:

9. Perforated Casings or Screens:

Not available from to
(Number per foot and size of perforations, or describe screen)
from to
from to
from to

10. Log of Well: (Describe each stratum or formation clearly, indicate if water bearing, and give thickness and depth as indicated.)

MATERIAL	Thickness (Feet)	Depth to Bottom (Feet)
Not available		

If log of well is not available, give name and address of driller. West Wall Drilling

4120 Market Street, Salem, Oregon

11. Infiltration Trench: Covered or open

Dimensions: Length ft. Minimum depth ft. Maximum depth ft.

Bottom width ft. Discharge g.p.m. Date of test

12. Tunnel: Type of lining

Dimensions: (Length, course, and cross sectional size)

Position of water bearing stratum with reference to portal of tunnel

Log of tunnel: (Preceding table for log of well may be used, if desired. Give footage from portal and character of materials, as pertinent)

13. Pumping Equipment:

(a) Pump Deep well turbine Capacity 300 g.p.m. (Make, type and size)

(b) Motor 15 H. P. electric (Type and horsepower)

14. Location of area irrigated or to be irrigated, or place of use if for purposes other than irrigation.


Township North or South	Range E. or W. of Willamette Meridian	Section	Forty-acre Tract	Number Acres To Be Irrigated	Date of Reclamation
11 S	3 W.	11	NW $\frac{1}{4}$ of NW $\frac{1}{4}$	Washing gravel	June 1, 1955

CS 4667
M.O. Salmon

Beginning South 1494.86 feet from a point on the South line of and N. 89°57' W. 1654.33 feet from the Southeast corner of the Matthew C. Chambers D.L.G. #40, in T. 11 S., R. 3 W. of the Will. Mer. 11th County, Oregon; running thence West 1087.31 feet; thence S. 4°30' W. 1580.43 feet to the North right-of-way line of the South Santiam Highway; thence N. 88°09' E. along said right-of-way 1206.12 feet; thence N. 0°13' E. 1536.65 feet to the place of beginning, and containing 40.91 acres, more or less, of which 0.91 acres lies in the County Road. Subject to the rights of the public in the use of said County road.

15. If the ground water supply is supplemental to an existing water supply, identification of any application for a permit, permit, certificate or adjudicated right to appropriate water made or held by the registrant.

Township 11 S Range 3 W. W.M.
North

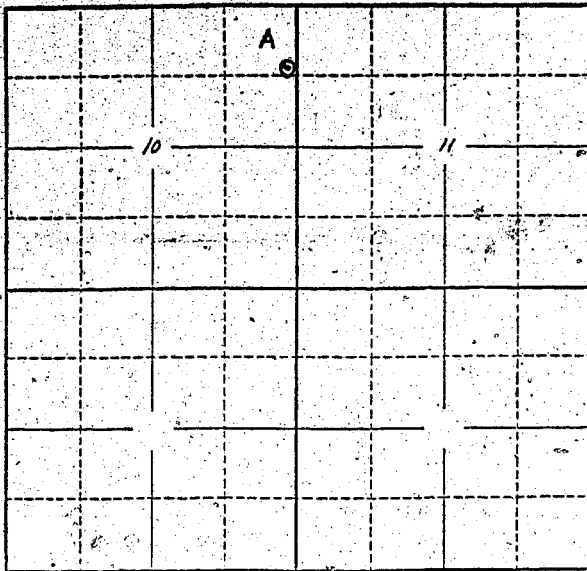

Locate well and acreage of irrigated land on plat.
Scale: 2" = 1 Mile

STATE OF OREGON

County of Linn } ss.

I, M. O. Salmon and Morse Bros., being first duly sworn, do hereby certify that I have read the foregoing Registration Statement and that all of the items therein contained are true to the best of my knowledge and belief.

M. O. Salmon
(Signature of Registrant)

Subscribed and sworn to before me this 30th day of June, 1958.

My commission expires NOTARY PUBLIC FOR OREGON
My Commission Expires March 14, 1961

C. Dean Johnson
(Notary Public)

(SEAL)

CERTIFICATE OF REGISTRATION

STATE OF OREGON }
County of Marion } ss.

This is to certify that the foregoing Registration Statement was received in the office of the State Engineer on the 2nd day of July, 1958, at 8:00 o'clock A. M. and has been duly recorded in said office in Book No. 8 of Registration Statements on page GR-1823

Witness my hand this 26th day of January, 1959

Lewis A. Stanley
(State Engineer)

By _____ (Deputy)

\$20.00

GR-1823