

# Registration Statement

## OF CLAIMANT OF RIGHT TO APPROPRIATE GROUND WATER

TO THE STATE ENGINEER OF OREGON:

I, Harold and Dorothea Lines

of Rt. 2, Box 226 X, Lebanon County of Linn

(Mailing address)

State of Oregon, do hereby make application for a certificate of registration as evidence of a right to appropriate ground water.

1. Source from which water is withdrawn is pump well  
(Flowing well, pump well, infiltration trench, or tunnel)

2. Location is: 5 miles north of Lebanon, Oregon  
(Approximate distance and direction from nearest city or town)

and is more particularly described as follows:

(a) 2904' S. and 1584' W. of NE corner S. 21, T. 11 S., R. 2 W.  
(Give distance and bearing to corner of section or other legal subdivision)  
being within NE 1/4 of SE 1/4 of Sec. 21, Twp. 11 S, Rge. 2 W  
(Smallest legal subdivision) (N. or S.) (E. or W.)

or (b) within limits of recorded platted property, town or city:

in Lot \_\_\_\_\_, Block \_\_\_\_\_ of \_\_\_\_\_  
(Name of plat or addition)  
County of Linn  
(If within city or town, give name)

3. Construction Work was begun on March 1945; was completed on March 1945  
(Date) (Date)

and the ground water claimed was first used for the purposes set out below on May 1945  
(Date)

since which time the water has been used continuously  
(Continuously or intermittently)

from May 1945 to present time  
(Date) (Date)

4. Quantity of water claimed and used is 600 gallons per minute; 120.0 acre feet per year.

5. Purpose or Purposes for which water is used Irrigation  
(Domestic, irrigation, municipal, manufacturing, industrial, etc.)

6. Description of Well: Depth 32' feet. Type Dug and cased  
(Dug or drilled)  
diameter 8 inches. Elevation of ground at well site 290 feet, mean sea level.  
(As near as known)  
Depth to water table 10 feet.

7. Capacity of Well: 200 g.p.m. with 8" feet drawdown.  
600 g.p.m. with 12" feet drawdown.

Date of test July 1, 1956

If Flowing Well: Measured discharge \_\_\_\_\_ g.p.m. on \_\_\_\_\_  
(Date)


Shut-in pressure at ground surface \_\_\_\_\_ lbs. per sq. in. on \_\_\_\_\_  
(Date)

Water is controlled by \_\_\_\_\_  
(Cap, valve, etc.)





Township 11 S Range 2 W W.M.  
North

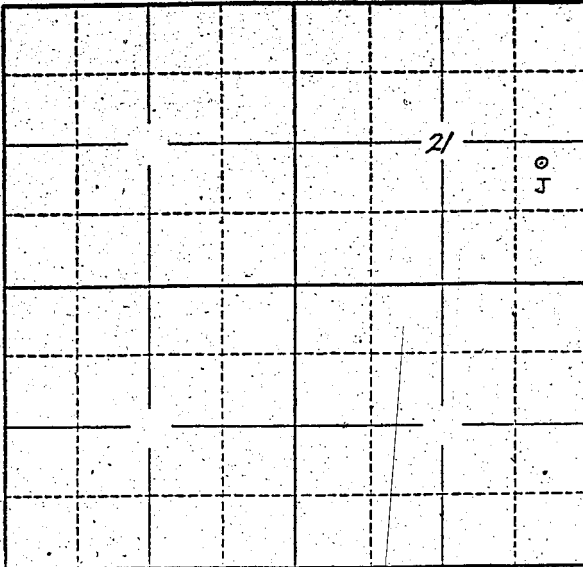

Locate well and acreage of irrigated land on plat.  
Scale: 2" = 1 Mile

STATE OF OREGON

County of LINN } ss.

I, Harold and Dorothea Lines, being first duly sworn, do hereby certify that I have read the foregoing Registration Statement and that all of the items therein contained are true to the best of my knowledge and belief.

Harold Lines  
(Signature of Registrant)

Subscribed and sworn to before me this 30 day of June, 1958

My commission expires July 22 - 1959

Patric Nich  
(Notary Public)

(SEAL)

**CERTIFICATE OF REGISTRATION**

STATE OF OREGON }  
County of Marion } ss.

This is to certify that the foregoing Registration Statement was received in the office of the State Engineer on the 2nd day of July, 1958, at 8:00 o'clock A. M. and has been duly recorded in said office in Book No. 8 of Registration Statements on page GR-1824

Witness my hand this 26th day of January, 1959

Laura A. Stanley  
(State Engineer)

By \_\_\_\_\_  
(Deputy)

GR - 1824

#16.50