

Registration Statement

OF CLAIMANT OF RIGHT TO APPROPRIATE GROUND WATER

TO THE STATE ENGINEER OF OREGON:

I, Oscar Kendall

of 630 South Fourth, Corvallis County of Benton

State of Oregon do hereby make application for a certificate of registration as evidence of a right to appropriate ground water.

1. Source from which water is withdrawn is Pump Well #2
(Flowing well, pump well, infiltration trench, or tunnel)

2. Location is: Approx 1 mile S.E.
(Approximate distance and direction from nearest city or town)

and is more particularly described as follows:

(a) 800 feet east 1200 feet north from NW4 corner Section 12
(Give distance and bearing to corner of section or other legal subdivision)

being within SW4 of NW4 of Sec. 12, Twp. 12S, Rge. 5W
(Smallest legal subdivision) (N. or S.) (E. or W.)

or (b) within limits of recorded platted property, town or city:

in Lot _____, Block _____ of _____
(Name of plat or addition)

County of _____
(If within city or town, give name)

3. Construction Work was begun on 1912; was completed on 1912
(Date) (Date)

and the ground water claimed was first used for the purposes set out below on 1912
(Date)

since which time the water has been used _____
(Continuously or intermittently)

from 1912 to 1912
(Date) (Date)

4. Quantity of water claimed and used is 550 gallons per minute; _____ acre feet per year.

5. Purpose or Purposes for which water is used _____
(Domestic, irrigation, municipal, manufacturing, industrial, etc.)

6. Description of Well: Depth _____ feet. Type _____
(Dug or drilled)

diameter 10 inches. Elevation of ground at well site 200 feet, mean sea level.
(As near as known)

Depth to water table _____ feet.

7. Capacity of Well: 550 g.p.m. with _____ feet drawdown.

550 g.p.m. with _____ feet drawdown.

Date of test _____

If Flowing Well: Measured discharge _____ g.p.m. on _____
(Date)

Shut-in pressure at ground surface _____ lbs. per sq. in. on _____
(Date)

Water is controlled by _____
(Cap, valve, etc.)

8. Casing: (Give diameter, commercial specifications and depth below ground surface of each casing size.)

10 inch diameter *Steel casing* from to feet
 inch diameter from to feet
 inch diameter from to feet
 inch diameter from to feet

Describe and show depth of shoe, plug, adapter, liner or other details:

9. Perforated Casings or Screens:

(Number per foot and size of perforations, or describe screen) from to
 from to
 from to
 from to

10. Log of Well: (Describe each stratum or formation clearly, indicate if water bearing, and give thickness and depth as indicated.)

MATERIAL	Thickness (Feet)	Depth to Bottom (Feet)

If log of well is not available, give name and address of driller:

11. Infiltration Trench: Covered or open

Dimensions: Length ft. Minimum depth ft. Maximum depth ft.

Bottom width ft. Discharge g.p.m. Date of test

12. Tunnel: Type of lining

Dimensions:
(Length, course, and cross sectional size)

Position of water bearing stratum with reference to portal of tunnel

Log of tunnel: (Preceding table for log of well may be used, if desired. Give footage from portal and character of materials, as pertinent.)

13. Pumping Equipment:

(a) Pump Fairbanks Morse - 5 hp Capacity 500 g.p.m.
(Make, type and size)


(b) Motor gas engine - and 25 hp
(Type and horsepower)

14. Location of area irrigated or to be irrigated, or place of use if for purposes other than irrigation.

Township North or South	Range E. or W. of Willamette Meridian	Section	Forty-acre Tract	Number Acres To Be Irrigated	Date of Reclamation
T12S	R5W	11	NE $\frac{1}{4}$ of NE $\frac{1}{4}$	7.2	1911
"	"	11	SE $\frac{1}{4}$ of NE $\frac{1}{4}$	5.2	"
"	"	12	NW $\frac{1}{4}$ of N $\frac{1}{2}$ of NW $\frac{1}{4}$	20.2	"
"	"	12	SW $\frac{1}{4}$ of N $\frac{1}{2}$ of NW $\frac{1}{4}$	20.2	"
"	"	12	NE $\frac{1}{4}$ of N $\frac{1}{2}$ of NW $\frac{1}{4}$	5	"
"	"	12	SE $\frac{1}{4}$ of N $\frac{1}{2}$ of NW $\frac{1}{4}$	4.2	"
				64.2	

15. If the ground water supply is supplemental to an existing water supply, identification of any application for a permit, permit, certificate or adjudicated right to appropriate water made or held by the registrant.

Township 12S Range 5W, W.M.
North

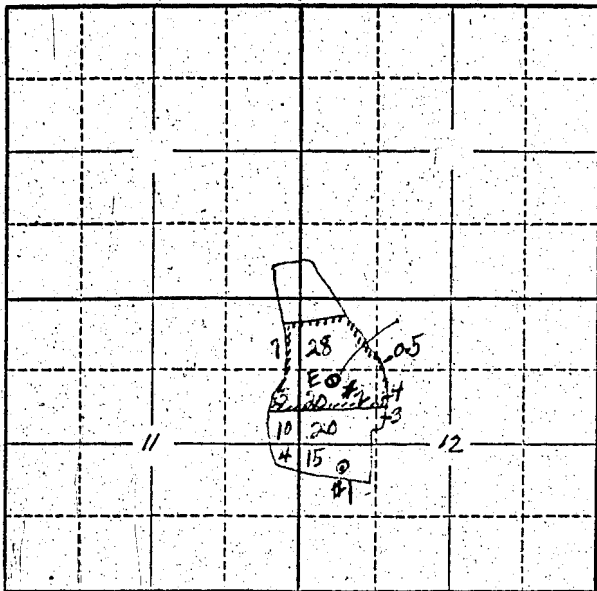

Locate well and acreage of irrigated land on plat.
Scale: 2" = 1 Mile

STATE OF OREGON

County of _____ } ss.

I, Quar..., being first duly sworn, do hereby certify that I have read the foregoing Registration Statement and that all of the items therein contained are true to the best of my knowledge and belief.

(Signature of Registrant)

Subscribed and sworn to before me this 30th day of June, 1958

My commission expires Feb. 14, 1961

E. H. Bailey
(Notary Public)

(SEAL)

CERTIFICATE OF REGISTRATION

STATE OF OREGON

County of Marion } ss.

This is to certify that the foregoing Registration Statement was received in the office of the State Engineer on the 2nd day of July, 1958, at 5:00 o'clock A. M. and has been duly recorded in said office in Book No. 12 of Registration Statements on page GR 2748

Witness my hand this 25th day of May, 1959

Walter A. Stanley
(State Engineer)

By _____
(Deputy)

GR 2748

\$ 20.25