

Registration Statement

OF CLAIMANT OF RIGHT TO APPROPRIATE GROUND WATER

TO THE STATE ENGINEER OF OREGON:

I, Hoyt Willoughby

of Route 2 Bay View Fairview County of Multnomah

State of Oregon, do hereby make application for a certificate of registration as evidence of a right to appropriate ground water.

1. Source from which water is withdrawn is Pump Well
(Flowing well, pump well, infiltration trench, or tunnel)

2. Location is: 2 miles North of Fairview Oregon
(Approximate distance and direction from nearest city or town)

and is more particularly described as follows:

(a) Chant 220' E. x 660' S. B. NW 1/4 of NW 1/4 of Sec 21-
(Give distance and bearing to corner of section or other legal subdivision)

being within NW 1/4 of NW 1/4 of Sec. 21, Twp. 11 N, Rge. 3 E
(Smallest legal subdivision) (N. or S.) (E. or W.)

or (b) within limits of recorded platted property, town or city:

in Lot _____, Block _____ of _____
(Name of plat or addition)

County of _____
(If within city or town, give name)

3. Construction Work was begun on April 17 1952; was completed on April 25 1952
(Date) (Date)

and the ground water claimed was first used for the purposes set out below on May 21 1952
(Date)

since which time the water has been used intermittently
(Continuously or intermittently)

from May 21 1952 to June 17 1958
(Date) (Date)

4. Quantity of water claimed and used is 340 gallons per minute; _____ acre feet per year.

5. Purpose or Purposes for which water is used irrigation

(Domestic, irrigation, municipal, manufacturing, industrial, etc.)

6. Description of Well: Depth 133 feet. Type Drilled
(Dug or drilled)

diameter 8 inches. Elevation of ground at well site 25 feet, mean sea level.
(As near as known)

Depth to water table 200' feet.

7. Capacity of Well: 340 g.p.m. with 8 feet drawdown.

_____ g.p.m. with _____ feet drawdown.

Date of test April 25 1952

If Flowing Well: Measured discharge _____ g.p.m. on _____
(Date)

Shut-in pressure at ground surface _____ lbs. per sq. in. on _____
(Date)

Water is controlled by _____
(Cap, valve, etc.)

8. Casing: (Give diameter, commercial specifications and depth below ground surface of each casing size.)

..... inch diameter from to feet
 inch diameter from to feet
 inch diameter from to feet
 inch diameter from to feet

Describe and show depth of shoe, plug, adapter, liner or other details:

9. Perforated Casings or Screens:

..... from to
(Number per foot and size of perforations, or describe screen)
 from to
 from to
 from to

10. Log of Well: (Describe each stratum or formation clearly, indicate if water bearing, and give thickness and depth as indicated.)

MATERIAL	Thickness (Feet)	Depth to Bottom (Feet)
This well was drilled by equipment installed		
by H. L. Gussing (XRD Records).		
Depth from City Road Northward		
Computed and operated April 25-1952		
I believe it would seem impossible to get		
Log of Well		

If log of well is not available, give name and address of driller. Qua & Co

11. Infiltration Trench: Covered or open Open well
Dimensions: Length _____ ft. Minimum depth _____ ft. Maximum depth _____ ft.
Bottom width _____ ft. Discharge _____ g.p.m. Date of test _____

12. Tunnel: Type of lining None
Dimensions: _____
(Length, course, and cross sectional size)
Position of water bearing stratum with reference to portal of tunnel _____

Log of tunnel: (Preceding table for log of well may be used, if desired. Give footage from portal and character of materials, as pertinent.)

13. Pumping Equipment:
(a) Pump Pipe No Flow Centrifugal 15H 3P Capacity 320 g.p.m.
(b) Motor 15 HORSE 3 PHASE
(Type and horsepower)


14. Location of area irrigated or to be irrigated, or place of use if for purposes other than irrigation.

Township North or South	Range E. or W. of Willamette Meridian	Section	Forty-acre Tract	Number Acres To Be Irrigated	Date of Reclamation
T1N	R3E	21	NW ¹ / ₄ of NW ¹ / ₄	20 Ac	1952
"	"	"	NE ¹ / ₄ + NW ¹ / ₄	10 30%	"

It was irrigated on the above described land.

15. If the ground water supply is supplemental to an existing water supply, identification of any application for a permit, permit, certificate or adjudicated right to appropriate water made or held by the registrant.

Township 1N Range 3E, W.M.
North

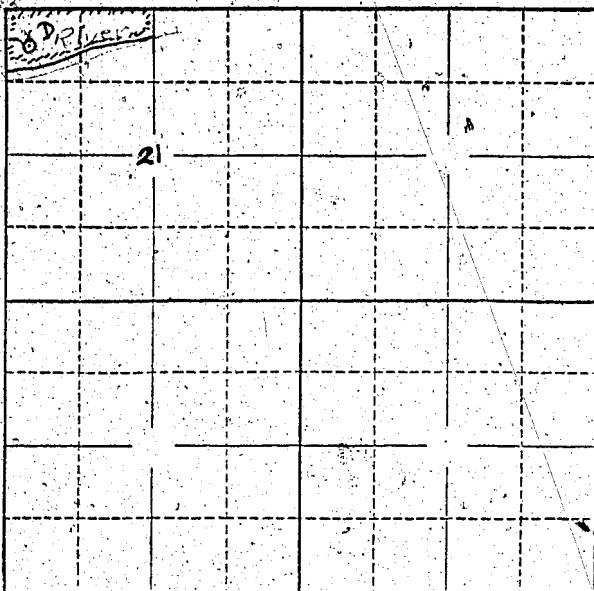

Locate well and acreage of irrigated land on plat.
Scale: 2" = 1 Mile

STATE OF OREGON

County of Washington } ss.




(Notary Public)

(SEAL)

CERTIFICATE OF REGISTRATION

STATE OF OREGON } ss.
County of Marion

This is to certify that the foregoing Registration Statement was received in the office of the State Engineer on the 20th day of June, 1959, at 1:00 o'clock P.M. and has been duly recorded in said office in Book No. 16 of Registration Statements on page GR 3893.

Witness my hand this 4th day of December, 1959

Sumner A. Stanley
(State Engineer)

\$1500

By _____ (Deputy)