

RECEIVED
JUL 10 1958
STATE ENGINEER
SALEM, OREGON

Registration No. GR - 1898

Certificate No. GR - 1833

Registration Statement

OF CLAIMANT OF RIGHT TO APPROPRIATE GROUND WATER

TO THE STATE ENGINEER OF OREGON:

I, HAROLD W. and DORIS E. RANSOM

of 785 Capitol St. N. E., Salem, Oregon County of Marion
(Mailing address)

State of OREGON, do hereby make application for a certificate of registration as evidence of a right to appropriate ground water.

1. Source from which water is withdrawn is: pump well
(Flowing well, pump well, infiltration trench, or tunnel)

2. Location is: 5 miles southeast of Turner
(Approximate distance and direction from nearest city or town)

and is more particularly described as follows:

(a) 1100 feet south and 700 feet west from NE corner of Section 14
(Give distance and bearing to corner of section or other legal subdivision)

being within NE quarter of NE quarter of Sec. 14, Twp. 9S, Rge. 2R
(Smallest legal subdivision) (N. or S.) (E. or W.)

or (b) within limits of recorded platted property, town or city:

in Lot _____, Block _____ of _____
(Name of plat or addition)

County of _____
(If within city or town, give name)

3. Construction Work was begun on July, 1949; was completed in July, 1949
(Date) (Date)

and the ground water claimed was first used for the purposes set out below in July, 1949
(Date)

since which time the water has been used intermittently
(Continuously or intermittently)

from 1949 to 1957
(Date) (Date)

4. Quantity of water claimed and used is 350 gallons per minute; _____ acre feet per year.

5. Purpose or Purposes for which water is used irrigation

(Domestic, irrigation, municipal, manufacturing, industrial, etc.)

6. Description of Well: Depth 130 feet. Type drilled
(Dug or drilled)

diameter 12 inches. Elevation of ground at well site _____ feet, mean sea level.
(As near as known)

Depth to water table 29 feet.

7. Capacity of Well: 188 g.p.m. with 60 feet drawdown.

250 g.p.m. with 110 feet drawdown.


Date of test July, 1949

If Flowing Well: Measured discharge _____ g.p.m. on _____
(Date)

Shut-in pressure at ground surface _____ lbs. per sq. in. on _____
(Date)

Water is controlled by _____
(Cap, valve, etc.)

Township 98 Range 2W W.M.
North

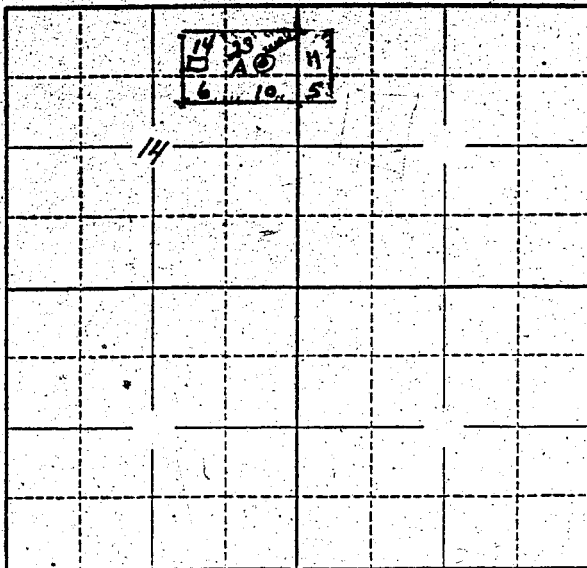

Locate well and acreage of irrigated land on plat.

Scale: 2" = 1 Mile

STATE OF OREGON
County of Marion

} ss.

I, Doris E. Ransom, being first duly sworn, do hereby certify that I have read the foregoing Registration Statement and that all of the items therein contained are true to the best of my knowledge and belief.

Harold W. and Doris E. Ransom

by Doris E. Ransom
(Signature of Registrant)

Subscribed and sworn to before me this 2nd day of July, 1958

My commission expires 2-13-1960

[Signature]
(Notary Public)

(SEAL)

CERTIFICATE OF REGISTRATION

STATE OF OREGON
County of Marion

} ss.

This is to certify that the foregoing Registration Statement was received in the office of the State Engineer on the 2nd day of July, 1958, at 8:00 o'clock A.M. and has been duly recorded in said office in Book No. 8 of Registration Statements on page GR-1833

Witness my hand this 26th day of January, 1959

[Signature]
(State Engineer)

By _____
(Deputy)

#20-85

GR-1833