

RECEIVED
NOV 17 1958

STATE ENGINEER
SALEM, OREGON

Registration No. GR. 1899

Certificate No. GR. 1834

Registration Statement

OF CLAIMANT OF RIGHT TO APPROPRIATE GROUND WATER

TO THE STATE ENGINEER OF OREGON:

I, Est. Harry D. Jeff Mr. Harry D. Jeff, Adm.
of Independence, R11 County of Polk
(Mailing address)

State of Oregon, do hereby make application for a certificate of registration as evidence of a right to appropriate ground water.

1. Source from which water is withdrawn is Pump well
(Flowing well, pump well, infiltration trench, or tunnel)

2. Location is: 2 mi. S. Independence
(Approximate distance and direction from nearest city or town)

and is more particularly described as follows:

(a) 2000 feet west & 1400 feet south from NE corner Section 4
(Give distance and bearing to corner of section or other legal subdivision)

being within SW 1/4 of NE 1/4 of Sec. 4, Twp. 9S, Rge. 4W
(Smallest legal subdivision) (N. or S.) (E. or W.)

or (b) within limits of recorded platted property, town or city:

in Lot _____, Block _____ of _____
(Name of plat or addition)

County of Polk
(If within city or town, give name)

3. Construction Work was begun on 6-1-36, was completed on 6-2-36
(Date) (Date)

and the ground water claimed was first used for the purposes set out below on 6-2-36
(Date)

since which time the water has been used Continuously
(Continuously or intermittently)

from 6-2-36 to 6-25-58
(Date) (Date)

4. Quantity of water claimed and used is 300 gallons per minute; _____ acre feet per year.

5. Purpose or Purposes for which water is used Irrigation
(Domestic, irrigation, municipal, manufacturing, industrial, etc.)

6. Description of Well: Depth 35 feet. Type drilled
(Dig or drilled)

diameter 12 inches. Elevation of ground at well site _____ feet, mean sea level.
(As near as known)

Depth to water table 10 feet.

7. Capacity of Well: 400 g.p.m. with 15 feet drawdown.

_____ g.p.m. with _____ feet drawdown.

Date of test 7-1-57

If Flowing Well: Measured discharge _____ g.p.m. on _____ (Date)

Shut-in pressure at ground surface _____ lbs. per sq. in. on _____ (Date)

Water is controlled by _____
(Cap, valve, etc.)

8. Casing: (Give diameter, commercial specifications and depth below ground surface of each casing size.)

12 inch diameter *steel casing* from *ground* to *35* feet
 inch diameter from to feet
 inch diameter from to feet
 inch diameter from to feet

Describe and show depth of shoe, plug, adapter, liner or other details:

9. Perforated Casings or Screens:

Perforated from *18* to *35 ft*
(Number per foot and size of perforations, or describe screen)
24 perforations per ft. from to
 from to
 from to

10. Log of Well: (Describe each stratum or formation clearly, indicate if water bearing, and give thickness and depth as indicated.)

MATERIAL	Thickness (Feet)	Depth to Bottom (Feet)
<i>Blue Clay</i>	<i>17 ft</i>	<i>17</i>
<i>Sand & Gravel</i>	<i>3 ft</i>	<i>20</i>
<i>Washed Gravel</i>	<i>14 ft</i>	<i>34</i>

If log of well is not available, give name and address of driller.

Logan Bros. (Deceased)

11. Infiltration Trench: Covered or open

Dimensions: Length _____ ft. Minimum depth _____ ft. Maximum depth _____ ft.
Bottom width _____ ft. Discharge _____ g.p.m. Date of test _____

12. Tunnel: Type of lining

Dimensions: _____
(Length, course, and cross sectional size)
Position of water bearing stratum with reference to portal of tunnel _____

Log of tunnel: (Preceding table for log of well may be used, if desired. Give footage from portal and character of materials, as pertinent.)

13. Pumping Equipment:


(a) Pump Gardner Denver 3" Sec 2 1/2 Dia. Capacity 30 g.p.m.
(Make, type and size)
(b) Motor 10 HP Direct Drive
(Type and horsepower)

14. Location of area irrigated or to be irrigated, or place of use if for purposes other than irrigation.

Township North or South	Range E. or W. of Willamette Meridian	Section	Forty-acre Tract	Number Acres To Be Irrigated	Date of Reclamation
T9S	R4W	4	SW 1/4 of NE 1/4	15.2	1936

15. If the ground water supply is supplemental to an existing water supply, identification of any application for a permit, permit, certificate or adjudicated right to appropriate water made or held by the registrant.

Township 9S Range 4W, W.M.
North

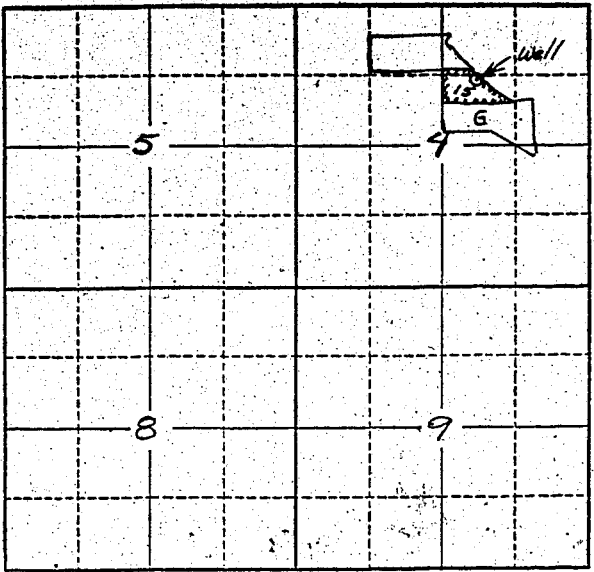

Locate well and acreage of irrigated land on plat.
Scale: 2" = 1 Mile

STATE OF OREGON }


(Signature of Registrant)

Subscribed and sworn to before me this 1st day of July, 1958

My commission expires 3-29-59
[Signature]
(Notary Public)

(SEAL)

CERTIFICATE OF REGISTRATION

STATE OF OREGON }
County of Marion } ss.

This is to certify that the foregoing Registration Statement was received in the office of the State Engineer on the 3rd day of July, 1958, at 8:00 o'clock A.M. and has been duly recorded in said office in Book No. 8 of Registration Statements on page GR-1834

Witness my hand this 26th day of January, 1959

Lewis A. Stanley
(State Engineer)

\$15.00

By _____
(Deputy)

GR - 1834