

# Registration Statement

## OF CLAIMANT OF RIGHT TO APPROPRIATE GROUND WATER

(Under Chapter 708, Oregon Laws 1955)

#1

TO THE STATE ENGINEER OF OREGON:

I, MIKE BRONEC

of Rt. 1, Hubbard County of Marion

State of Oregon, do hereby make application for a certificate of registration as evidence of a right to appropriate ground water.

1. Source from which water is withdrawn is Pump well #1  
(Flowing well, pump well, infiltration trench, or tunnel)

2. Location is: About 1 mi. west of Hubbard, Ore.  
(Approximate distance and direction from nearest city or town)

and is more particularly described as follows:

(a) 782' N. from W 1/4 Cor. Sec. 33  
(Give distance and bearing to corner of section or other legal subdivision)

being within S 1/4 NW 1/4 of Sec. 33, Twp. 4, Rge. 1 W  
(Smallest legal subdivision) (N. or S.) (E. or W.)

or (b) within limits of recorded platted property, town or city:

in Lot \_\_\_\_\_, Block \_\_\_\_\_ of \_\_\_\_\_  
(Name of plat or addition)

County of \_\_\_\_\_

(If within city or town, give name)

3. Construction Work was begun on Feb. 6th, 1952; was completed on March 3, 1952  
(Date) (Date)

and the ground water claimed was first used for the purposes set out below on About June 1, 1952  
(Date)

since which time the water has been used Intermittently  
(Continuously or Intermittently)

from June 1952 to Sept. 20, 1955  
(Date) (Date)

4. Quantity of water claimed and used is 490 gallons per minute; \_\_\_\_\_ acre feet per year.

5. Purpose or Purposes for which water is used Irrigation

(Domestic, irrigation, municipal, manufacturing, industrial, etc.)

6. Description of Well: Depth 128 feet. Type Drilled and perforated 10 ft.  
(Dug or drilled)

diameter 10.125 inches. Elevation of ground at well site 313 feet, mean sea level.  
(As near as known)

Depth to water table 23 feet.

7. Capacity of Well: 520 g.p.m. with 41 feet drawdown.

250 g.p.m. with 22 feet drawdown.

Date of test March 3, 1952

If Flowing Well: Measured discharge \_\_\_\_\_ g.p.m. on \_\_\_\_\_  
(Date)


Shut-in pressure at ground surface \_\_\_\_\_ lbs. per sq. in. on \_\_\_\_\_  
(Date)

Water is controlled by \_\_\_\_\_  
(Cap, valve, etc.)





Township 45 Range 1W W.M.  
North

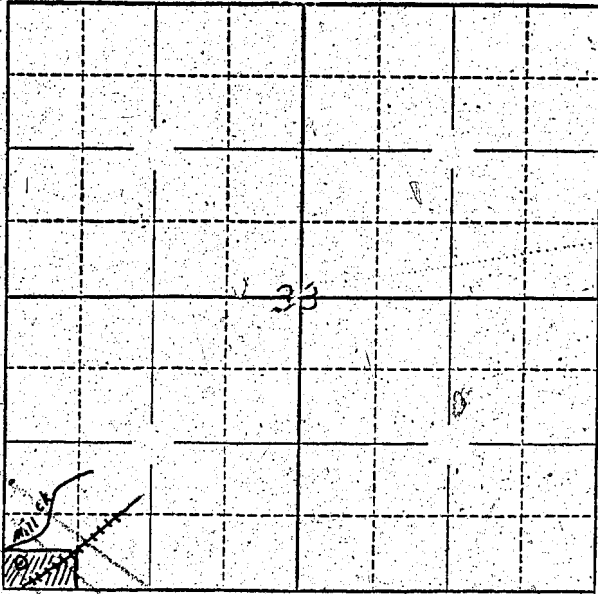

Locate well and acreage of irrigated land on plat.  
Scale: 2" = 1 Mile

SEE MAP  
IN FILE  
GR-17

STATE OF OREGON }  
County of Marion } ss.

I, Mike Bronec, being first duly sworn, do hereby certify that I have read the foregoing Registration Statement and that all of the items therein contained are true to the best of my knowledge and belief.

Mike Bronec  
(Signature of Registrant)

Subscribed and sworn to before me this 30 day of September, 1955.

My commission expires 9/27/58

Jeanie Baxter  
(Notary Public)

(SEAL)

**CERTIFICATE OF REGISTRATION**

STATE OF OREGON }  
County of Marion } ss.

*For Certificate see pg. GR-16 K*

This is to certify that the foregoing Registration Statement was received in the office of the State Engineer on the \_\_\_\_\_ day of \_\_\_\_\_, 19\_\_\_\_, at \_\_\_\_\_ o'clock \_\_\_\_\_ M. and has been duly recorded in said office in Book No. \_\_\_\_\_ of Registration Statements on page \_\_\_\_\_

Construction shall be completed by \_\_\_\_\_, 19\_\_\_\_, and the water completely applied to beneficial use by \_\_\_\_\_, 19\_\_\_\_.

Witness my hand this \_\_\_\_\_ day of \_\_\_\_\_, 19\_\_\_\_.

Lewis A. Stanley  
(State Engineer)

By \_\_\_\_\_  
(Deputy)

**Registration Statement****OF CLAIMANT OF RIGHT TO APPROPRIATE GROUND WATER**

(Under Chapter 703, Oregon Laws 1955.)

**TO THE STATE ENGINEER OF OREGON:**

#2

I, NIKE BRONECof Rt. 1, Hubbard County of MarionState of Oregon, do hereby make application for a certificate of registration as evidence of a right to appropriate ground water.1. Source from which water is withdrawn is Flowing well and creek  
(Flowing well, pump well, infiltration trench, or tunnel)2. Location is: 1/4 mi. from Hubbard West  
(Approximate distance and direction from nearest city or town)

and is more particularly described as follows:

(a) 110 feet N., 720 Ft. W. from the center of Sec. 33  
(Give distance and bearing to corner of section, or other legal subdivision)being within (Smallest legal subdivision) of Sec. 33, Twp. h, Rge. 1 W  
(N. or S.) (E. or W.)

or (b) within limits of recorded platted property, town or city:

in Lot \_\_\_\_\_, Block \_\_\_\_\_ of \_\_\_\_\_  
(Name of plat or addition)

(If within city or town, give name) County of \_\_\_\_\_

3. Construction Work was begun on March 1952; was completed on March 1952  
(Date) (Date)and the ground water claimed was first used for the purposes set out below on About May 1952  
(Date)since which time the water has been used: Intermittently  
(Continuously or intermittently)from May 1952 to Sept. 1955  
(Date) (Date)4. Quantity of water claimed and used is 500 gallons per minute; \_\_\_\_\_ acre feet per year.5. Purpose or Purposes for which water is used Irrigation of crops

(Domestic, irrigation, municipal, manufacturing, industrial, etc.)

6. Description of Well: Depth 85 feet. Type Drilled  
(Dug or drilled)diameter 8 inches. Elevation of ground at well site 113 Ft. feet, mean sea level.  
(As near as known)

Depth to water table \_\_\_\_\_ feet.

7. Capacity of Well: \_\_\_\_\_ g.p.m. with \_\_\_\_\_ feet drawdown

\_\_\_\_\_ g.p.m. with \_\_\_\_\_ feet drawdown.

Date of test \_\_\_\_\_

If Flowing Well: Measured discharge 200 g.p.m. on May 1952  
(Date)Shut-in pressure at ground surface 15 lbs. per sq. in. on May 1952  
(Date)Water is controlled by Valve  
(Cap, valve, etc.)

8. Casing: (Give diameter, commercial specifications and depth below ground surface of each casing size.)

8" ID inch diameter 8.5/8" OD 24.70# from Top to 83 feet  
 inch diameter from to feet  
 inch diameter from to feet  
 inch diameter from to feet

Describe and show depth of shoe, plug, adapter, liner or other details:

8" Coupler for Shoe (Welded)

9. Perforated Casings or Screens:


Mills Perforator: from to  
 (Number per foot and size of perforations, or describe screen)  
 8 Rows 8 cuts to the row 3/8 X 2 " from 76 to 83  
 from to  
 from to

10. Log of Well: (Describe each stratum or formation clearly, indicate if water bearing, and give thickness and depth as indicated.)

MATERIAL		Thickness (Feet)	Depth to Bottom (Feet)
From Top	to 18'	Peat & shale	
	18 to 20'	Fine blue sand	
	20 to 40	Soft blue shale	
	40 to 70	Black Sand	
		Flowed at 50' and again at 68'	
	70 to 71	Blue Shale	
	71 to 75	Black Sand & small gravel	
	75 to 83	Black sand & coarse gravel	
		Flowed at 83'	
		Welded Thread. and Capped with 3" Valve	
		flowed through valve at 120 G.P.M.	



Township 4S Range 1W, W.M.  
North

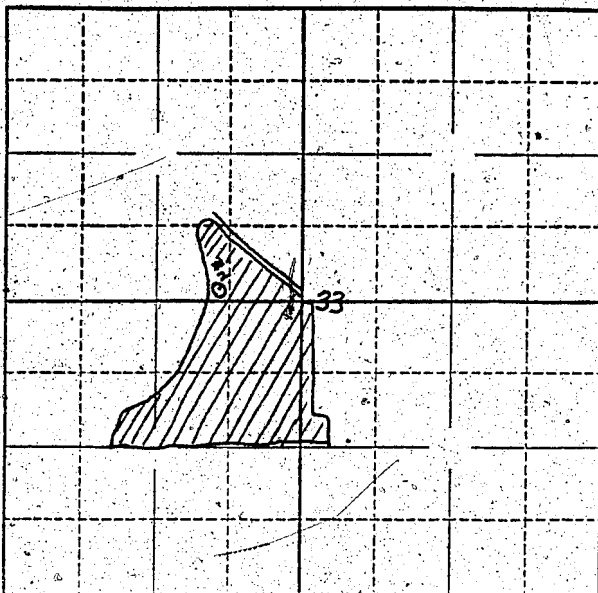

Locate well and acreage of irrigated land on plat.  
Scale: 2" = 1 Mile

STATE OF OREGON

County of Marion } ss.

I, Mike Bronec, being first duly sworn, do hereby certify that I have read the foregoing Registration Statement and that all of the items therein contained are true to the best of my knowledge and belief.

Mike Bronec  
(Signature of Registrant)

Subscribed and sworn to before me this 30 day of September, 1955.

My commission expires 9/27/58

Jeanie Baxter  
(Notary Public)

(SEAL)

### CERTIFICATE OF REGISTRATION

STATE OF OREGON

County of Marion } ss.

For Certificate see page GR-16K.

This is to certify that the foregoing Registration Statement was received in the office of the State Engineer on the \_\_\_\_\_ day of \_\_\_\_\_, 19\_\_\_\_, at \_\_\_\_\_ o'clock \_\_\_\_\_ M. and has been duly recorded in said office in Book No. \_\_\_\_\_ of Registration Statements on page \_\_\_\_\_.

Construction shall be completed by \_\_\_\_\_, 19\_\_\_\_, and the water completely applied to beneficial use by \_\_\_\_\_, 19\_\_\_\_.

Witness my hand this \_\_\_\_\_ day of \_\_\_\_\_, 19\_\_\_\_.

Lewis A. Stanley  
(State Engineer)

By \_\_\_\_\_

(Deputy)

GR-16 G



# Registration Statement

## OF CLAIMANT OF RIGHT TO APPROPRIATE GROUND WATER

(Under Chapter 708, Oregon Laws 1955.)

TO THE STATE ENGINEER OF OREGON:

# 3

I, MIKE BRONEC

of Rt. #1, Hubbard County of Marion

State of Oregon, do hereby make application for a certificate of registration as evidence of a right to appropriate ground water.

1. Source from which water is withdrawn is Flowing and pump well  
(Flowing well, pump well, infiltration trench, or tunnel)

2. Location is: About 3/4 mile south from Hubbard  
(Approximate distance and direction from nearest city or town)

and is more particularly described as follows:

(a) 400' E & 250' N from SW Corner of Sec. 33  
(Give distance and bearing to corner of section or other legal subdivision)

being within SW 1/4 SW 1/4 of Sec. 33, Twp. 4, Rge. 1 W 1/2  
(Smallest legal subdivision) (N. or S.) (E. or W.)

or (b) within limits of recorded platted property, town or city:

in Lot \_\_\_\_\_, Block \_\_\_\_\_ of \_\_\_\_\_  
(Name of plat or addition)

County of \_\_\_\_\_  
(If within city or town, give name)

3. Construction Work was begun on April 6, 1954 was completed on April 15, 1954  
(Date) (Date)

and the ground water claimed was first used for the purposes set out below on May 1955  
(Date)

since which time the water has been used Intermittently  
(Continuously or intermittently)

from May 1955 to Aug. 1955  
(Date) (Date)

4. Quantity of water claimed and used is 400 gallons per minute; \_\_\_\_\_ acre feet per year.

5. Purpose or Purposes for which water is used Irrigation of crops  
(Domestic, irrigation, municipal, manufacturing, industrial, etc.)

6. Description of Well: Depth 97 feet. Type Drilled  
(Dug or drilled)

diameter 8 inches. Elevation of ground at well site 129 feet, mean sea level.  
(As near as known)

Depth to water table None feet. Running in winter \_\_\_\_\_

7. Capacity of Well: 328 g.p.m. with 27 feet drawdown.

200 g.p.m. with 11 feet drawdown.

Date of test April 15, 1954

If Flowing Well: Measured discharge 130 g.p.m. on April 1954  
(Date)

Shut-in pressure at ground surface \_\_\_\_\_ lbs. per sq. in. on \_\_\_\_\_  
(Date)

Water is controlled by Valve  
(Cap, valve, etc.)

8. Casing: (Give diameter, commercial specifications and depth below ground surface of each casing size.)

8 inch diameter ..... from Top to bottom feet  
inch diameter ..... from ..... to ..... feet  
inch diameter ..... from ..... to ..... feet  
inch diameter ..... from ..... to ..... feet

Describe and show depth of shoe, plug, adapter, liner or other details: .....

9. Perforated Casings or Screens:

Perforated ..... from 90 ft. to 95 ft.  
(Number per foot and size of perforations, or describe screen)

..... from ..... to .....

..... from ..... to .....

..... from ..... to .....

10. Log of Well: (Describe each stratum or formation clearly, indicate if water bearing, and give thickness and depth as indicated.)

MATERIAL	Thickness (Feet)	Depth to Bottom (Feet)
Mud	22	
Sand water bearing	43	
Blue Clay	13	
Black sand	12	
Gravel	7	97

If log of well is not available, give name and address of driller. ....

11. Infiltration Trench: Covered or open .....

Dimensions: Length ..... ft. Minimum depth ..... ft. Maximum depth ..... ft.  
Bottom width ..... ft. Discharge ..... g.p.m. Date of test .....

12. Tunnel: Type of lining .....

Dimensions: .....  
(Length, course, and cross sectional size)  
Position of water bearing stratum with reference to portal of tunnel .....

Log of tunnel: (Preceding table for log of well may be used, if desired. Give footage from portal and character of materials, as pertinent.)

13. Pumping Equipment (we used centrifugal pump 240 gal. run with D.2. tractor.)


(a) Pump Centrifugal ..... Capacity 240 ..... g.p.m.  
(Make, type and size)  
(b) Motor D. 2. tractor .....  
(Type and horsepower)

14. Location of area irrigated or to be irrigated, or place of use if for purposes other than irrigation.

Township North or South	Range E. or W. of Willamette Meridian	Section	Forty-acre Tract	Number Acres To Be Irrigated	Date of Reclamation
4	1 W	33	18	18	1955
5	1 W	4		11	Oct. 1956
(Of the above about 14 acres irrigated in 1955)					

15. If the ground water supply is supplemental to an existing water supply, identification of any application for a permit, permit, certificate or adjudicated right to appropriate water made or held by the registrant.

Township 44 Range 1W, W.M.  
North

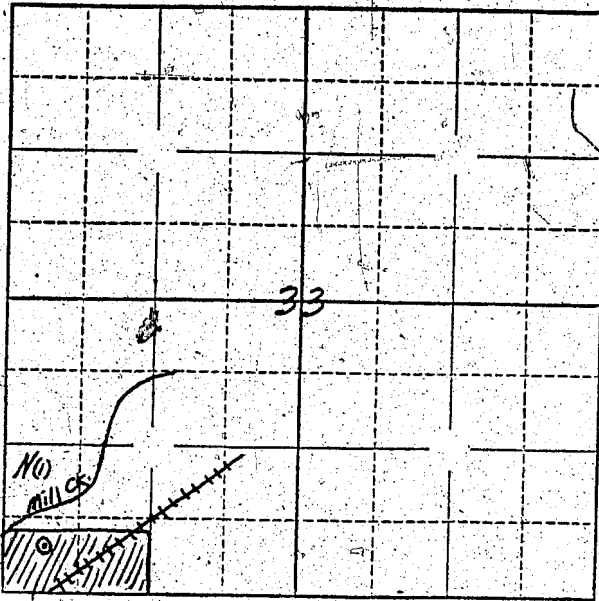

Locate well and acreage of irrigated land on plat.  
Scale: 2" = 1 Mile

STATE OF OREGON

County of Marion } ss.

I, Mike Bronce, being first duly sworn, do hereby certify that I have read the foregoing Registration Statement and that all of the items therein contained are true to the best of my knowledge and belief.

Mike Bronce  
(Signature of Registrant)

Subscribed and sworn to before me this 30 day of September, 1955

My commission expires 9/27/58

Jeanie Baxter  
(Notary Public)

(SEAL)

### CERTIFICATE OF REGISTRATION

STATE OF OREGON

County of Marion } ss.

This is to certify that the foregoing Registration Statement was received in the office of the State Engineer on the 30th day of September, 1955, at 10:05 o'clock A. M. and has been duly recorded in said office in Book No. 1 of Registration Statements on page 16

Construction shall be completed by October 1, 1956 and the water shall be completely applied to beneficial use by October 1, 1956.

Witness my hand this 24th day of February, 1956

Lewis A. Stanley  
(State Engineer)

By \_\_\_\_\_  
(Deputy)