

Registration Statement

REGISTRATION NO. OR-190
CERTIFICATE NO. OR-176

OF CLAIMANT OF RIGHT TO APPROPRIATE GROUND WATER

(Under Chapter 708, Oregon Laws 1955.)

TO THE STATE ENGINEER OF OREGON:

I, Melvin R. DuRette
of St. Paul County of Marion

State of Oregon, do hereby make application for a certificate of registration as evidence of a right to appropriate ground water.

1. Source from which water is withdrawn is Pump Well
(Flowing well, pump well, infiltration trench, or tunnel)

2. Location is: 3.5 miles N.E. of St. Paul, Oregon
(Approximate distance and direction from nearest city or town)

and is more particularly described as follows:

(a) 1306.8' N 55° W, 548.35' W 1893.0' N 47° 35' W 750' from S. S. E. Cor. Peter Pappin D.L.C.
(Give distance and bearing to corner of section or other legal subdivision)

being within S.E. 1/4 N.W. 1/4 of Sec. 15, Twp. 4 S, Rge. 2 W
(Smallest legal subdivision) (N. or S.) (E. or W.)

or (b) within limits of recorded platted property, town or city:

in Lot _____, Block _____ of _____
(Name of plat or addition)

(If within city or town, give name) _____ County of _____

3. Construction Work was begun on before before April 21, 1953 was completed on before April 21, 1953
(Date) (Date)

and the ground water claimed was first used for the purposes set out below on 15 April, 53
(Date)

since which time the water has been used Continuously through each irrigation season
(Continuously or Intermittently)

from 53 to 56
(Date) (Date)

4. Quantity of water claimed and used is 425 gallons per minute; _____ acre feet per year.

5. Purpose or Purposes for which water is used irrigation

(Domestic, Irrigation, municipal, manufacturing, industrial, etc.)

6. Description of Well: Depth 110 feet. Type drilled
(Dug or drilled)

Diameter 1.8" inches. Elevation of ground at well site _____ feet, mean sea level.
(As near as known)

Depth to water table 38 feet.

7. Capacity of Well: 600 g.p.m. with 65 feet drawdown.

500 g.p.m. with 58 feet drawdown.

Date of test April 21, 1953

If Flowing Well: Measured discharge _____ g.p.m. on _____
(Date)

Shut-in pressure at ground surface _____ lbs. per sq. in. on _____
(Date)

Water is controlled by _____
(Cap, valve, etc.)

8. Casing: (Give diameter, commercial specifications and depth below ground surface of each casing size.)

18 inch diameter from 0 to 110 feet
 inch diameter from to feet
 inch diameter from to feet
 inch diameter from to feet

Describe and show depth of shoe, plug, adapter, liner or other details:


9. Perforated Casings or Screens:

from to
 (Number per foot and size of perforations, or describe screen)
 from to
 from to
 from to

10. Log of Well: (Describe each stratum or formation clearly, indicate if water bearing, and give thickness and depth as indicated.)

MATERIAL	Thickness (Feet)	Depth to Bottom (Feet)
Soil	2.0'	2'
Blue tough clay	7.0'	9'
Yellow Clay carrying some water	36.0'	45'
Grey Clay	20.0'	65 65'
Mucky Sandy Clay - Black	14.0'	79'
Sand - Lots of Water - couldn't stop - would not hold pipe	9.0'	88
Sandy Clay - Grey	5.0	93
Tough Clay	10.0'	103
Soft dark Clay - Sandy	2.0'	105'
Fine sand	3.0'	108'
Sand & Small Gravel	2.0'	110'

Township 1 S Range 2 W W.M.
North

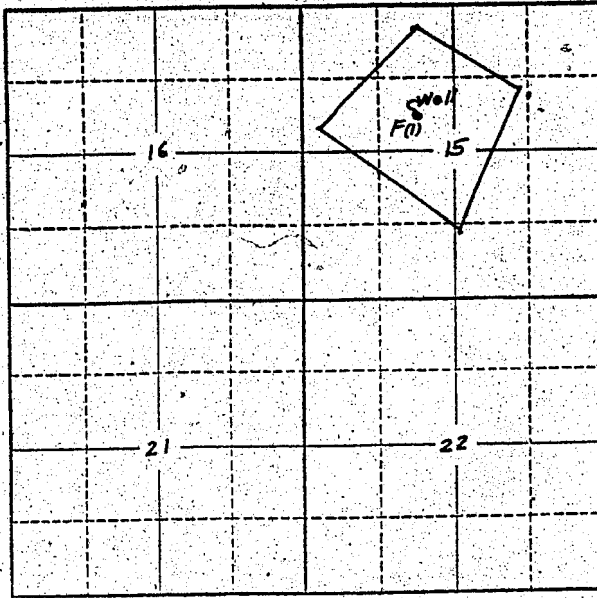

Locate well and acreage of irrigated land on plat.
Scale: 2" = 1 Mile

STATE OF OREGON

County of Marion

} ss.

I, Melvin R. DuRette, being first duly sworn, do hereby certify that I have read the foregoing Registration Statement and that all of the items therein contained are true to the best of my knowledge and belief.

Melvin R. DuRette
(Signature of Registrant)

Subscribed and sworn to before me this 25th day of May, 1956

My commission expires September 2, 1956

Marvin Rogers
(Notary Public)

(SEAL)

CERTIFICATE OF REGISTRATION

STATE OF OREGON

County of Marion

} ss.

This is to certify that the foregoing Registration Statement was received in the office of the State Engineer on the 25th day of May, 1956, at 1 o'clock P.M. and has been duly recorded in said office in Book No. 1 of Registration Statements on page GR-176 C

Witness my hand this 8th day of October, 1956

Lewis A. Stanley
(State Engineer)

By _____ (Deputy)

GR-176 C