

Registration No. GR. 1900

Certificate No. GR. 1835

Registration Statement

OF CLAIMANT OF RIGHT TO APPROPRIATE GROUND WATER

TO THE STATE ENGINEER OF OREGON:

I, Lynwood D. McCarty

of 440 Wilkes Drive Eugene County of Lane
(Mailing address)

State of Oregon, do hereby make application for a certificate of registration as evidence of a right to appropriate ground water.

1. Source from which water is withdrawn is Pump Well
(Flowing well, pump well, infiltration trench, or tunnel)

2. Location is: 6 Miles north of Eugene off River Road East on Wilkes Drive
(Approximate distance and direction from nearest city or town)

and is more particularly described as follows: 100 feet west & 200 feet north from SW corner Section 1,

(a) In SE corner of SW 1/4 SW 1/4
(Give distance and bearing to corner of section or other legal subdivision)

being within SW 1/4 of SW 1/4 of Sec. I, Twp. 17 S, Rge. 4 West
(Smallest legal subdivision) (E. or S.) (E. or W.)

or (b) within limits of recorded platted property, town or city:

in Lot _____, Block _____ of _____
(Name of plat or addition)

County of _____
(If within city or town, give name)

3. Construction Work was begun on Sept. 8, 1948; was completed on Sept. 12, 1948
(Date) (Date)

and the ground water claimed was first used for the purposes set out below on June 20, 1949
(Date)

since which time the water has been used Intermittently
(Continuously or Intermittently)

from 1949 to 1957
(Date) (Date)

4. Quantity of water claimed and used is 36.4 gallons per minute; 19.5 acre feet per year.

5. Purpose or Purposes for which water is used Pasture Irrigation
(Domestic, irrigation, municipal, manufacturing, industrial, etc.)

6. Description of Well: Depth 19 feet. Type Driven
(Dug or drilled)

diameter 3 inches. Elevation of ground at well site 377 feet, mean sea level.
(As near as known)

Depth to water table 6 feet.

7. Capacity of Well: unknown g.p.m. with _____ feet drawdown.

_____ g.p.m. with _____ feet drawdown.

Date of test _____


If Flowing Well: Measured discharge _____ g.p.m. on _____
(Date)

Shut-in pressure at ground surface _____ lbs. per sq. in. on _____
(Date)

Water is controlled by _____
(Cap, valve, etc.)

Township 17 south Range 4 West of W.M.

North

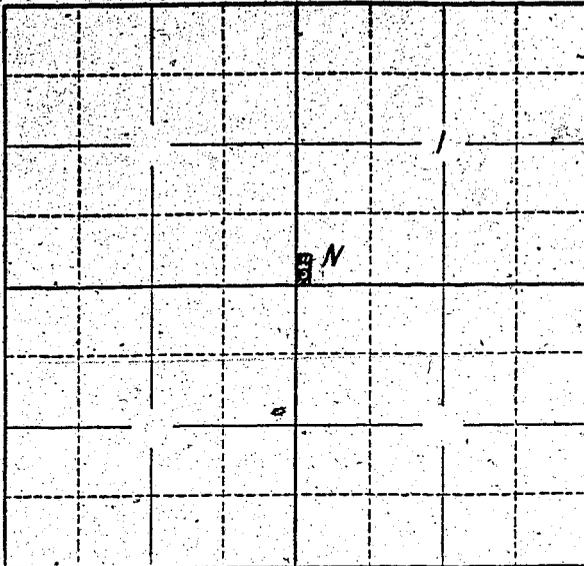

Locate well and acreage of irrigated land on plat.

Scale: 2" = 1 Mile

STATE OF OREGON

County of LAKE

ss.

I, Lynnwood D. McCarty, being first duly sworn, do hereby certify that I have read the foregoing Registration Statement and that all of the items therein contained are true to the best of my knowledge and belief.

Lynnwood D. McCarty
(Signature of Registrant)

Subscribed and sworn to before me this 14 day of January, 1958

My commission expires 4/19/60

Joan S. Ware
(Notary Public)

(SEAL)

CERTIFICATE OF REGISTRATION

STATE OF OREGON

County of Marion

ss.

This is to certify that the foregoing Registration Statement was received in the office of the State Engineer on the 3rd day of July, 1958, at 9:00 o'clock A. M. and has been duly recorded in said office in Book No. 8 of Registration Statements on page 6R-1835

Witness my hand this 26th day of January, 1959.

Lewis A. Stanley
(State Engineer)

By _____ (Deputy)

\$15.00

GR - 1835