

Registration Statement

OF CLAIMANT OF RIGHT TO APPROPRIATE GROUND WATER

TO THE STATE ENGINEER OF OREGON:

I, Jack Pesheck

of Rt. 2, Box 360, Albany County of Linn
(Mailing address)

State of Oregon, do hereby make application for a certificate of registration as evidence of a right to appropriate ground water.

1. Source from which water is withdrawn is Pump Well No. 2
(Flowing well, pump well, infiltration trench, or tunnel)

2. Location is: 10 Miles North of Albany, Oregon
(Approximate distance and direction from nearest city or town)

and is more particularly described as follows:

(a) 2343' S. and 1518' W. of NE corner S. 5, T. 10 S., R. 3 W.
(Give distance and bearing to corner of section or other legal subdivision)

being within SW $\frac{1}{4}$ of NE $\frac{1}{4}$ of Sec. 5, Twp. 10 S, Rge. 3 W
(Smallest legal subdivision) (N. or S.) (E. or W.)

or (b) within limits of recorded platted property, town or city:

in Lot _____, Block _____ of _____
(Name of plat or addition)

County of Linn
(If within city or town, give name)

3. Construction Work was begun on April 1948; was completed on April 1948
(Date) (Date)

and the ground water claimed was first used for the purposes set out below on April 1948
(Date)

since which time the water has been used continuously
(Continuously or intermittently)

from April 1948 to present time
(Date) (Date)

4. Quantity of water claimed and used is 180 gallons per minute; 117.0 acre feet per year.

5. Purpose or Purposes for which water is used Irrigation

(Domestic, irrigation, municipal, manufacturing, industrial, etc.)

6. Description of Well: Depth 23 feet. Type Driven
(Dug or drilled)

diameter 4 inches. Elevation of ground at well site 180 feet, mean sea level.
(As near as known)

Depth to water table 15 feet.

7. Capacity of Well: _____ g.p.m. with _____ feet drawdown.

_____ g.p.m. with _____ feet drawdown.


Date of test Not Tested

If Flowing Well: Measured discharge _____ g.p.m. on _____
(Date)

Shut-in pressure at ground surface _____ lbs. per sq. in. on _____
(Date)

Water is controlled by _____
(Cap, valve, etc.)

Township 10 Range 3 W, W.M.
North

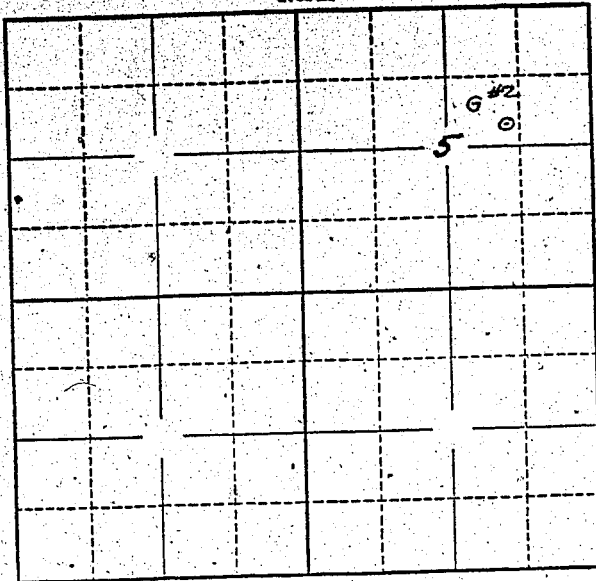

Locate well and acreage of irrigated land on plat.
Scale: 2" = 1 Mile

STATE OF OREGON

County of LINNA

} ss.

I, Jack Pesheck, being first duly sworn, do hereby certify that I have read the foregoing Registration Statement and that all of the items therein contained are true to the best of my knowledge and belief.

Jack Pesheck
(Signature of Registrant)

Subscribed and sworn to before me this 2nd day of July, 19 55

My commission expires 8/19/59

Howard Carpenter
(Notary Public)

(SEAL)

CERTIFICATE OF REGISTRATION

STATE OF OREGON

County of Marion

} ss.

This is to certify that the foregoing Registration Statement was received in the office of the State Engineer on the 3rd day of July, 19 55, at 8:00 o'clock A. M. and has been duly recorded in said office in Book No. 8 of Registration Statements on page GR-1837

Witness my hand this 26th day of January, 19 59

Henry A. Stenley
(State Engineer)

By _____ (Deputy)

\$15.00

GR - 1837