

RECEIVED
1958
STATE ENGINEER
SALESIAN OREGON

Registration No. GR. 1807
Certificate No. GR. 1840

Registration Statement

OF CLAIMANT OF RIGHT TO APPROPRIATE GROUND WATER

Well No. 1

TO THE STATE ENGINEER OF OREGON:

I, City of Phoenix
of PO Box 327, Phoenix County of Jackson
(Mailing address)

State of Oregon do hereby make application for a certificate of registration as evidence of a right to appropriate ground water.

1. Source from which water is withdrawn is flowing well, tunnel & pump
(Flowing well, pump well, infiltration trench, or tunnel)

2. Location is: 1/2 mile southeast of Phoenix
(Approximate distance and direction from nearest city or town)

and is more particularly described as follows: 925 feet east & 200 feet south from E 1/4 Sec. 16.

(a) 870' ~~370'~~ south of N.E. corner of D.L.C. # 55
(Give distance and bearing to corner of section or other legal subdivision)

being within NE 1/4 of NW 1/4 of the SW 1/4 of Sec. 15, Twp. 38 S Rge. 1 W
(Smallest legal subdivision) (N. or S.) (E. or W.)

or (b) within limits of recorded platted property, town or city:

in Lot _____, Block _____ of _____
(Name of plat or addition)

County of _____
(If within city or town, give name)

3. Construction Work was begun on About 1912; was completed on unknown
(Date) (Date)

and the ground water claimed was first used for the purposes set out below on 1913
(Date)

since which time the water has been used continuously
(Continuously or intermittently)

from 1913 to July 1, 1958 (present time)
(Date) (Date)

4. Quantity of water claimed and used is 250 gallons per minute; _____ acre feet per year.

5. Purpose or Purposes for which water is used municipal

(Domestic, irrigation, municipal, manufacturing, industrial, etc.)

6. Description of Well: Depth 700 feet. Type drilled
(Dug or drilled)

diameter 8 inches. Elevation of ground at well site 500 feet, mean sea level.
(As near as known)

Depth to water table 6 feet.

7. Capacity of Well 250 g.p.m. with _____ feet drawdown.

_____ g.p.m. with _____ feet drawdown.

Date of test Driller's records unavailable

If Flowing Well: Measured discharge 50 g.p.m. on _____
(Date)

Shut-in pressure at ground surface _____ lbs. per sq. in. on _____
(Date)

Water is controlled by slopes into underground tunnel reservoir
(Cap, valve, etc.)

8. Casing: (Give diameter, commercial specifications and depth below ground surface of each casing size.)

8 inch diameter from unknown to _____ feet
 _____ inch diameter from _____ to _____ feet
 _____ inch diameter from _____ to _____ feet
 _____ inch diameter from _____ to _____ feet

Describe and show depth of shoe, plug, adapter, liner or other details: _____

9. Perforated Casings or Screens:

Casing has been cut to allow water from _____ to _____
(Number per foot and size of perforations, or describe screen)
to flow into tunnel reservoir from _____ to _____
 _____ from _____ to _____
 _____ from _____ to _____

10. Log of Well: (Describe each stratum or formation clearly, indicate if water bearing, and give thickness and depth as indicated.)

MATERIAL	Thickness (Feet)	Depth to Bottom (Feet)
<p>Water is supposed to flow from about 20' depth. Well was a first antesian.</p>		

If log of well is not available, give name and address of driller. *not available as driller has died; records lost*

11. Infiltration Trench: Covered or open _____

Dimensions: Length _____ ft. Minimum depth _____ ft. Maximum depth _____ ft.

Bottom width _____ ft. Discharge _____ g.p.m. Date of test _____

12. Tunnel: Type of lining *Redwood*

Dimensions: *12' diameter, 16' long, approximately*
(Length, course, and cross-sectional size)

Position of water bearing stratum with reference to portal of tunnel *city below water-*

flows from about 200' depth through perforation into tunnel. Tunnel receives water from other city well; all is then pumped to reservoir

13. Pumping Equipment:

(a) Pump *Jacuzzi Jet 4 stage* Capacity *275* g.p.m.
(Make, type and size)

(b) Motor *1800 RPM 20 H.P. 3 phase*
(Type and horsepower)


14. Location of area irrigated or to be irrigated, or place of use if for purposes other than irrigation.

Township North or South	Range E. or W. of Willamette Meridian	Section	Forty-acre Tract	Number Acres To Be Irrigated	Date of Reclamation
385	1W	9	SE 1/4	Municipal	1913
385	1W	9	S 1/2 N.E. 1/4	Municipal	1913
385	1W	9	E 1/2 S.W. 1/4	Municipal	1913
385	1W	10	S.W. 1/4	Municipal	1913
385	1W	15	N.W. 1/4	Municipal	1913
385	1W	15	N 1/2 S.W. 1/4	Municipal	1913
385	1W	16	N.E. 1/4	Municipal	1913
385	1W	16	N 1/2 SE 1/4	Municipal	1913
<i>Being all lands within or adjacent to the city limits of Phoenix Oregon</i>					

15. If the ground water supply is supplemental to an existing water supply, identification of any application for a permit, permit, certificate or adjudicated right to appropriate water made or held by the registrant.

City has applied for registration of 1 other well July 1, 1958

Township 355 Range 1W W.M.
North

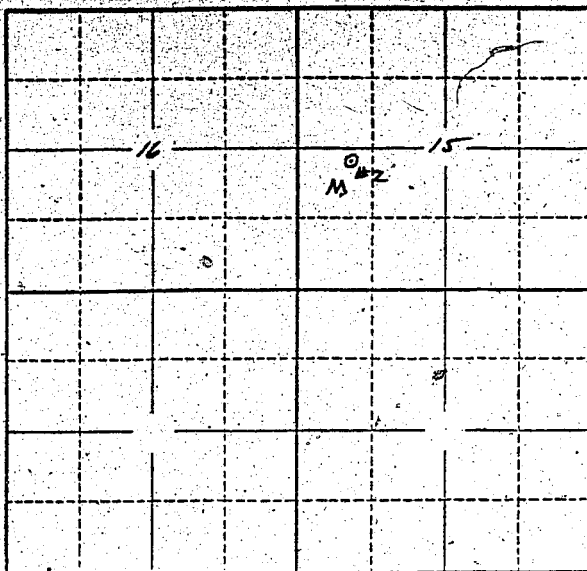

Locate well and acreage of irrigated land on plat.
Scale: 2" = 1 Mile

STATE OF OREGON

County of JACKSON

} ss.

I, John Q. Stewart Jr., being first duly sworn, do hereby certify that I have read the foregoing Registration Statement and that all of the items therein contained are true to the best of my knowledge and belief.

John Q. Stewart Jr.
(Signature of Registrant)

Subscribed and sworn to before me this 2nd day of July, 19 58

My commission expires

Ernest M. Madde
(Notary Public)

(SEAL)

NOTARY PUBLIC FOR OREGON
MY COMMISSION EXPIRES JUNE 17, 1960

CERTIFICATE OF REGISTRATION

STATE OF OREGON

County of Marion

} ss.

This is to certify that the foregoing Registration Statement was received in the office of the State Engineer on the 3rd day of July, 19 58, at 8:00 o'clock A.M. and has been duly recorded in said office in Book No. 8 of Registration Statements on page GR-1840

Witness my hand this 26th day of January, 19 59

Lewis A. Stanley
(State Engineer)

By

(Deputy)

\$ 20.00

GR - 1840