

# Registration Statement

REGISTRATION NO. GR 1842  
CERTIFICATE NO. GR-1842

## OF CLAIMANT OF RIGHT TO APPROPRIATE GROUND WATER

(Under Chapter 786, Oregon Laws 1955.)

TO THE STATE ENGINEER OF OREGON:

I, ALVIN J. NAZAC

of SALEM County of POLK

State of OREGON, do hereby make application for a certificate of registration as evidence of a right to appropriate ground water.

1. Source from which water is withdrawn is pump well  
(Flowing well, pump well, infiltration trench, or tunnel)

2. Location is: 2 miles N.W. of Salem, Oregon  
(Approximate distance and direction from nearest city or town)

and is more particularly described as follows:

(a) 450 E. and 200' So. of Water Street from SW corner of NW 1/4 of SE 1/4  
(Give distance and bearing to corner of section or other legal subdivision)

being within S.W. 1/4 of S.E. 1/4 of Sec. 9, Twp. 75, Rge. 3 W  
(Smallest legal subdivision) (N. or S.) (E. or W.)

or (b) within limits of recorded platted property, town or city:

in Lot \_\_\_\_\_, Block \_\_\_\_\_ of \_\_\_\_\_  
(Name of plat or addition)

County of POLK  
(If within city or town, give name)

3. Construction Work was begun on June 1940; was completed on June 1940  
(Date) (Date)

and the ground water claimed was first used for the purposes set out below on June 1940  
(Date)

since which time the water has been used intermittently  
(Continuously or intermittently)

from June 1940 to July 1958  
(Date) (Date)

4. Quantity of water claimed and used is 185 gallons per minute; 33 acre feet per year.

5. Purpose or Purposes for which water is used irrigation

(Domestic, irrigation, municipal, manufacturing, industrial, etc.)

6. Description of Well: Depth 30 feet. Type drilled  
(Dug or drilled)

diameter 8 5/8 inches. Elevation of ground at well site 130 feet, mean sea level.  
(As near as known)

Depth to water table 10 feet.

7. Capacity of Well: unknown g.p.m. with unknown feet drawdown.

unknown g.p.m. with unknown feet drawdown.

Date of test none

If Flowing Well: Measured discharge \_\_\_\_\_ g.p.m. on \_\_\_\_\_  
(Date)

Shut-in pressure at ground surface \_\_\_\_\_ lbs. per sq. in. on \_\_\_\_\_  
(Date)

Water is controlled by \_\_\_\_\_  
(Cap, valve, etc.)

8. Casing: (Give diameter, commercial specifications and depth below ground surface of each casing size.)

$4 \frac{1}{8}$  inch diameter steel casing @ 277 from 0 to  $25 \frac{1}{2}$  feet  
 inch diameter from to feet  
 inch diameter from to feet  
 inch diameter from to feet

Describe and show depth of shoe, plug, adapter, liner or other details:

9. Perforated Casings or Screens:

unknown from to  
(Number per foot and size of perforations, or describe screen)  
 from to  
 from to  
 from to

10. Log of Well: (Describe each stratum or formation clearly, indicate if water bearing, and give thickness and depth as indicated.)

MATERIAL	Thickness (Feet)	Depth to Bottom (Feet)
<u>unknown</u>		
<u>sand &amp; gravels</u>		

If log of well is not available, give name and address of driller: H.A. Robinson

11. Infiltration Trench: Covered or open \_\_\_\_\_  
Dimensions: Length \_\_\_\_\_ ft. Minimum depth \_\_\_\_\_ ft. Maximum depth \_\_\_\_\_ ft.  
Bottom width \_\_\_\_\_ ft. Discharge \_\_\_\_\_ g.p.m. Date of test \_\_\_\_\_

12. Tunnel: Type of lining \_\_\_\_\_  
Dimensions: \_\_\_\_\_ (Length, course, and cross sectional size)  
Position of water bearing stratum with reference to portal of tunnel \_\_\_\_\_

Log of tunnel: (Preceding table for log of well may be used, if desired. Give footage from portal and character of materials, as pertinent.)


13. Pumping Equipment:  
(a) Pump \_\_\_\_\_ Centrifugal \_\_\_\_\_ Capacity 180 \_\_\_\_\_ g.p.m.  
(b) Motor \_\_\_\_\_ 7 $\frac{1}{2}$  H.P. \_\_\_\_\_ 240 Volt \_\_\_\_\_

14. Location of area irrigated or to be irrigated, or place of use if for purposes other than irrigation.

Township North or South	Range E. or W. of Willamette Meridian	Section	Four-Corner Tract	Number Acres To Be Irrigated	Date of Reclamation
74	3W	9	S.W. $\frac{1}{4}$ of S.E. $\frac{1}{4}$	20.1	June 1940
75	3W	9	N.W. $\frac{1}{4}$ of S.E. $\frac{1}{4}$	11.4	June 1940
				31.5 <sup>2</sup>	

15. If the ground water supply is supplemental to an existing water supply, identification of any application for a permit, permit, certificate or adjudicated right to appropriate water made or held by the registrant.

Township 75 Range 3W W.M.  
North

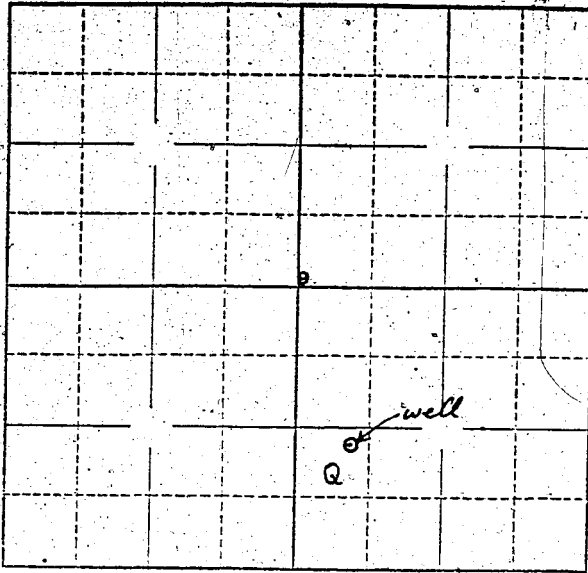

Locate well and acreage of irrigated land on plat.  
Scale: 2" = 1 Mile

STATE OF OREGON

County of Marion } ss.

I, Alvin G. Mazac, being first duly sworn, do hereby certify that I have read the foregoing Registration Statement and that all of the items therein contained are true to the best of my knowledge and belief.

Alvin G. Mazac  
(Signature of Registrant)

Subscribed and sworn to before me this 3rd day of July, 1958

My commission expires 12th June 1961 Wm. S. Bartholomew  
(Notary Public)

(SEAL)

CERTIFICATE OF REGISTRATION

STATE OF OREGON } ss.  
County of Marion

This is to certify that the foregoing Registration Statement was received in the office of the State Engineer on the 3rd day of July, 1958, at 2<sup>00</sup> o'clock P. M. and has been duly recorded in said office in Book No. 8 of Registration Statements on page GR-1842.

Witness my hand this 26<sup>th</sup> day of January, 1959

Lewis A. Stanley  
(State Engineer)

By \_\_\_\_\_ (Deputy)

GR-1842

#1530