

Registration Statement

OF CLAIMANT OF RIGHT TO APPROPRIATE GROUND WATER

TO THE STATE ENGINEER OF OREGON:

I, J. H. Rehberg

of Route #1, Box 274 Cathey County of Clackamas
(Mailing address)

State of Oregon do hereby make application for a certificate of registration as evidence of a right to appropriate ground water.

1. Source from which water is withdrawn is Pump
(Flowing well, pump well, infiltration trench, or tunnel)

2. Location is: 2 Miles West of Damascus on Rock Creek Road
(Approximate distance and direction from nearest city or town)

and is more particularly described as follows: 750 feet south & 2250 feet west from NE Corner Sect. 7.

(a) 132 ft S 336 ft E, from S28 Rods of the 1/4 sec. G.O.R. on N line of said sec.

being within N.W. 1/4 N.E. 1/4 of Sec. 7, Twp. 2 S, Rge. 3 E
(Smallest legal subdivision) (N. or S.) (E. or W.)

or (b) within limits of recorded platted property, town or city:

in Lot _____, Block _____ of _____
(Name of plat or addition)

County of _____
(If within city or town, give name)

3. Construction Work was begun on Aug 1, 1950; was completed on Sept. 15, 1950
(Date) (Date)

and the ground water claimed was first used for the purposes set out below on April 23, 1951
(Date)

since which time the water has been used intermittently
(Continuously or Intermittently)

from 4/23/51 to 7/1/58
(Date) (Date)

4. Quantity of water claimed and used is 70 gallons per minute; _____ acre feet per year.

5. Purpose or Purposes for which water is used Farm Irrigation

(Domestic, irrigation, municipal, manufacturing, industrial, etc.)

6. Description of Well: Depth 266 feet. Type Drilled

(Dug or drilled)

diameter 8 in inches. Elevation of ground at well site 500 ft feet, mean sea level.
(As near as known)

Depth to water table 127 feet.

7. Capacity of Well: 83 g.p.m. with 102 feet drawdown.

60 g.p.m. with 79 feet drawdown.

Date of test Sept 11, 1950

If Flowing Well: Measured discharge _____ g.p.m. on _____
(Date)

Shut-in pressure at ground surface _____ lbs. per sq. in. on _____
(Date)

Water is controlled by _____
(Cap, valve, etc.)

8. Casing: (Give diameter, commercial specifications and depth below ground surface of each casing size.)

8 inch diameter from 0 to 266 feet
..... inch diameter from to feet
..... inch diameter from to feet
..... inch diameter from to feet

Describe and show depth of shoe, plug, adapter, liner or other details:
8" Shoe at 266

9. Perforated Casings or Screens:

(Number per foot and size of perforations, or describe screen) from 130 to 250
..... from to
3/16 x 2 1/4 Mill Knife from to
..... from to

10. Log of Well: (Describe each stratum or formation clearly, indicate if water bearing, and give thickness and depth as indicated.)

MATERIAL	Thickness (Feet)	Depth to Bottom (Feet)
Yellow Clay & Boulders	0	40
Cemented & gravel	40	255
Loose water bearing gravel	255	266

If log of well is not available, give name and address of driller.

11. Infiltration Trench: Covered or open _____

Dimensions: Length _____ ft. Minimum depth _____ ft. Maximum depth _____ ft.

Bottom width _____ ft. Discharge _____ g.p.m. Date of test _____

12. Tunnel: Type of lining _____

Dimensions: _____
(Length, course, and cross sectional size)

Position of water bearing stratum with reference to portal of tunnel _____

Log of tunnel: (Preceding table for log of well may be used, if desired. Give footage from portal and character of materials, as pertinent.)

13. Pumping Equipment:

(a) Pump Fairbanks Morse, Fig 6977 Pomona 10 H.P. Capacity 100 g.p.m.
(Make, type and size)

(b) Motor Westinghouse C.S.P. Frame 284
(Type and horsepower)


14. Location of area irrigated or to be irrigated, or place of use if for purposes other than irrigation.

Township North or South	Range E. or W. of Williamsite Meridian	Section	Forty-acre Tract	Number Acres To Be Irrigated	Date of Reclamation
2 S	3 E	7	NW 1/4 of NE 1/4 25.00 acres	13.0	1951

15. If the ground water supply is supplemental to an existing water supply, identification of any application for a permit, permit, certificate or adjudicated right to appropriate water made or held by the registrant.

Township 2 S Range 3 E W.M.

North NW 1/4 NE 1/4

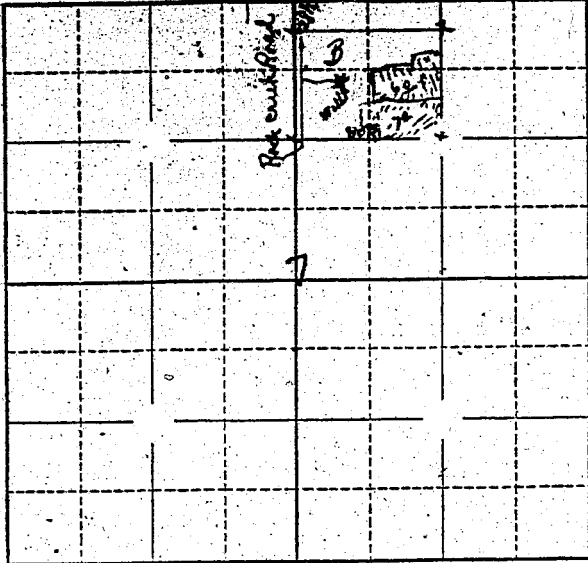

Locate well and acreage of irrigated land on plat.

Scale: 2" = 1 Mile

STATE OF OREGON

County of _____ } ss.

I, J. H. Rabbers, being first duly sworn, do hereby certify that I have read the foregoing Registration Statement and that all of the items therein contained are true to the best of my knowledge and belief.

J. H. Rabbers
(Signature of Registrant)

Subscribed and sworn to before me this 22nd day of July, 1958

My commission expires _____
My Commission Expires May 4, 1962

Winton A. Ebel
(Notary Public)

(SEAL)

CERTIFICATE OF REGISTRATION

STATE OF OREGON

County of Marion } ss.

This is to certify that the foregoing Registration Statement was received in the office of the State Engineer on the 7th day of July, 1958, at 8:00 o'clock A.M. and has been duly recorded in said office in Book No. 8 of Registration Statements on page GR-1850

Witness my hand this 26th day of January, 1959

Lewis A. Stanley
(State Engineer)

\$1,500

By _____
(Deputy)

GR - 1850