

Registration Statement

OF CLAIMANT OF RIGHT TO APPROPRIATE GROUND WATER

TO THE STATE ENGINEER OF OREGON:

I, Thomas Babb

of Rt. # 1 Ex 637 Lake Grove County of Clackamas
(Mailing address)

State of Oregon, do hereby make application for a certificate of registration as evidence of a right to appropriate ground water.

1. Source from which water is withdrawn is Pump Well
(Flowing well, pump well, infiltration trench, or tunnel)

2. Location is: Lake Grove 3 miles S.W. from Oswego
(Approximate distance and direction from nearest city or town)

and is more particularly described as follows: 1100 feet east and 600 feet south from W & corner

(a) Lot # 100 Lake View Villas
(Give distance and bearing to corner of section or other legal subdivision)

being within NW 1/4 of SW 1/4 of E. of Willamette Meridian of Sec. 8, Twp. 2 S, Rge. 1 E
(Smallest legal subdivision) (N. or S.) (E. or W.)

or (b) within limits of recorded platted property, town or city:

in Lot _____, Block 100 of Lake View Villas
(Name of plat or addition)

County of Clackamas
(If within city or town, give name)

3. Construction Work was begun on 1945; was completed on 1945
(Date) (Date)

and the ground water claimed was first used for the purposes set out below on 1945
(Date)

since which time the water has been used Continuously for irrigation
(Continuously or intermittently)

from 1945 to 1958
(Date) (Date)

4. Quantity of water claimed and used is 50 GPM gallons per minute; _____ acre feet per year.

5. Purpose or Purposes for which water is used House and irrigation

(Domestic, irrigation, municipal, manufacturing, industrial, etc.)

6. Description of Well: Depth 102' feet. Type Drilled
(Dug or drilled)

diameter 8" inches. Elevation of ground at well site 100' feet, mean sea level.
(As near as known)

Depth to water table 102' feet.

7. Capacity of Well: 100 g.p.m. with none feet drawdown.

? g.p.m. with ? feet drawdown.


Date of test 1945

If Flowing Well: Measured discharge _____ g.p.m. on _____
(Date)

Shut-in pressure at ground surface _____ lbs. per sq. in. on _____
(Date)

Water is controlled by _____
(Cap, valve, etc.)

Township 25 Range 1E W.M.
North

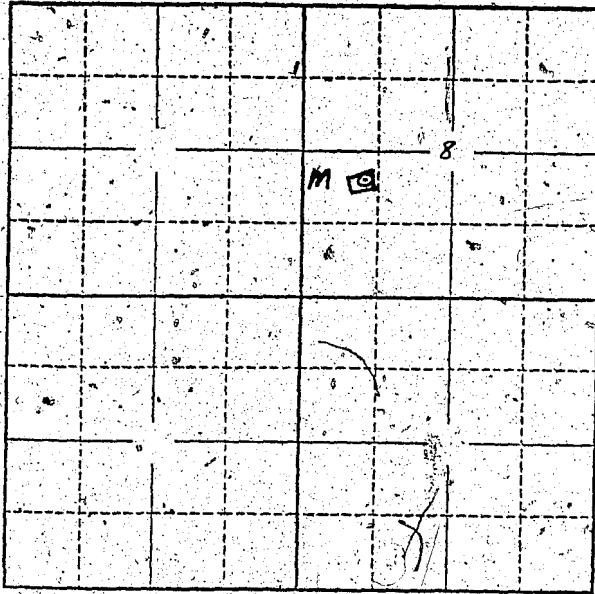

Locate well and acreage of irrigated land on plat.
Scale: 2" = 1 Mile

STATE OF OREGON

County of Washington } ss.

I, Thomas Babb, being first duly sworn, do hereby certify that I have read the foregoing Registration Statement and that all of the items therein contained are true to the best of my knowledge and belief.

Thomas Babb
(Signature of Registrant)

Subscribed and sworn to before me this 2nd day of July, 1952

My commission expires March 10, 1961

Alvin K. Johnson
(Notary Public)

(SEAL)

CERTIFICATE OF REGISTRATION

STATE OF OREGON

County of Marion } ss.

This is to certify that the foregoing Registration Statement, was received in the office of the State Engineer on the _____ day of _____, 1952, at _____ o'clock _____ M. and has been duly recorded in said office in Book No. 16 of Registration Statements on page GR-3840

Witness my hand this 20th day of December, 1959

Lewis A. Stanley
(State Engineer)

By _____ (Deputy)

GR 3840

#15.00