

Registration Statement

OF CLAIMANT OF RIGHT TO APPROPRIATE GROUND WATER

TO THE STATE ENGINEER OF OREGON:

I, V.E. Anderson

of Harbor Box 25 Oregon County of Curry

State of Oregon, do hereby make application for a certificate of registration as evidence of a right to appropriate ground water.

1. Source from which water is withdrawn is Pump well
(Flowing well, pump well, infiltration trench, or tunnel)

2. Location is: 2.5 miles from Brookings, Oregon, South, on Pedrioli Drive
(Approximate distance and direction from nearest city or town)

and is more particularly described as follows:

(a) 246 feet North and 265 feet East of the SE Cor. of D.L.C. No. 40
(Give distance and bearing to corner of section or other legal subdivision)

being within SE 1/4 (NW 1/4 of SE 1/4) of Sec. 9, Twp. 41 S, Rge. 13 W
(Smallest legal subdivision) (N. or S.) (E. or W.)

or (b) within limits of recorded platted property, town or city:

in Lot _____, Block _____ of _____
(Name of plat or addition)

County of _____
(If within city or town, give name)

3. Construction Work was begun on July 1951; was completed on Aug. 1951
(Date) (Date)

and the ground water claimed was first used for the purposes set out below on 20 Aug. 1951
(Date)

since which time the water has been used yearly
(Continuously or intermittently)

from May 1 to Sept. 1
(Date) (Date)

4. Quantity of water claimed and used is unknown 90 gallons per minute; _____ acre feet per year. 3in. irrigation pipe, 9 rotary sprinklers, outlets 3/32 and 5/32 in.

5. Purpose or Purposes for which water is used irrigation of lily bulbs

(Domestic, irrigation, municipal, manufacturing, industrial, etc.)

6. Description of Well: Depth 57 feet. Type Drilled

(Dug or drilled)

diameter 10 inches. Elevation of ground at well site 103 feet, mean sea level.

(As near as known)

Depth to water table _____ feet. Unknown

7. Capacity of Well: _____ g.p.m. with _____ feet drawdown. unknown

_____ g.p.m. with _____ feet drawdown. unknown

Date of test _____ No test

If Flowing Well: Measured discharge _____ g.p.m. on _____
(Date)

Shut-in pressure at ground surface _____ lbs. per sq. in. on _____
(Date)

Water is controlled by _____
(Cap. valve, etc.)

8. **Casing:** (Give diameter, commercial specifications and depth below ground surface of each casing size.)

10 inch diameter from 0 to 57 feet
 inch diameter from to feet
 inch diameter from to feet
 inch diameter from to feet

Describe and show depth of shoe, plug, adapter, liner or other details:
 perforated casing about 5 or 6 feet

9. **Perforated Casings or Screens:**

perforated casing (Number unknown) from 51 or 52 to 57 feet
(Number per foot and size of perforations, or describe screen)
 from to
 from to
 from to

10. **Log of Well:** (Describe each stratum or formation clearly, indicate if water bearing, and give thickness and depth as indicated.)

	MATERIAL	Thickness (Feet)	Depth to Bottom (Feet)
Unknown			

If log of well is not available, give name and address of driller. Foss Starr, Crescent City, Calif.

11. Infiltration Trench: Covered or open _____
Dimensions: Length _____ ft. Minimum depth _____ ft. Maximum depth _____ ft.
Bottom width _____ ft. Discharge _____ g.p.m. Date of test _____

12. Tunnel: Type of lining _____
Dimensions: _____
(Length, course, and cross sectional size)
Position of water bearing stratum with reference to portal of tunnel _____

Log of tunnel: (Preceding table for log of well may be used, if desired. Give footage from portal and character of materials, as pertinent.)

13. Pumping Equipment:
(a) Pump Pacific Turbine _____ Capacity ⁹⁰ ~~unknown~~ g.p.m.
(Make, type and size)
(b) Motor General Electric 5 H.P. Electric _____
(Type and horsepower)


14. Location of area irrigated or to be irrigated, or place of use if for purposes other than irrigation.

Township North or South	Range E. or W. of Williams's Meridian	Section	Forty-acre Tract	Number Acres To Be Irrigated	Date of Reclamation
41 S	13W	9	NW $\frac{1}{4}$ SE $\frac{1}{4}$	9.95	20 Aug. 1951
41 S	13W	9	SW $\frac{1}{4}$ SE $\frac{1}{4}$	0.45	20 Aug. 1951
Total 10.4 acres					

15. If the ground water supply is supplemental to an existing water supply, identification of any application for a permit, permit, certificate or adjudicated right to appropriate water made or held by the registrant.

See attached map

Township 41 S Range 13 W, W.M.
North

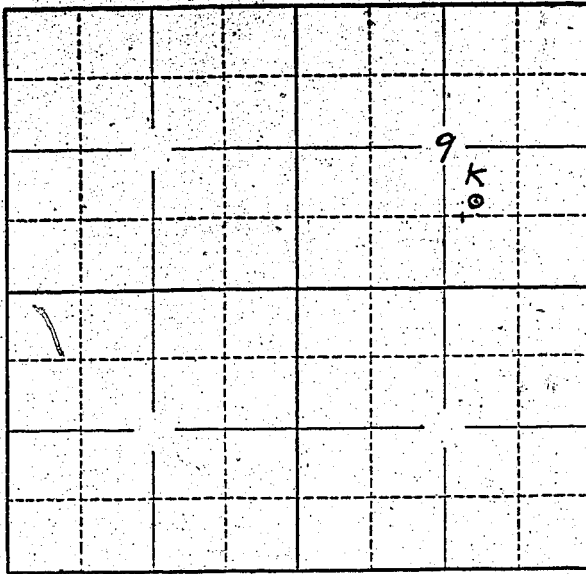

Locate well and acreage of irrigated land on plat.

Scale: 2" = 1 Mile

STATE OF OREGON

County of Curry } ss.

I, J. E. Anderson, being first duly sworn, do hereby certify that I have read the foregoing Registration Statement and that all of the items therein contained are true to the best of my knowledge and belief.

J. E. Anderson
(Signature of Registrant)

Subscribed and sworn to before me this 15th day of July, 1958

My commission expires _____
Clara D. Walker
County Clerk, Curry Co., Ore.

(SEAL)

CERTIFICATE OF REGISTRATION

STATE OF OREGON } ss.
County of Marion

This is to certify that the foregoing Registration Statement was received in the office of the State Engineer on the 7th day of July, 1958, at 1:00 o'clock A.M. and has been duly recorded in said office in Book No. 8 of Registration Statements on page GR-1852

Witness my hand this 26th day of January, 1959

Levin A. Stanley
(State Engineer)

15.00

By _____ (Deputy)

GR - 1852