Registration No. GR 1924

Certificate No. GR 3937

Registration Statement

OF CLAIMANT OF RIGHT TO APPROPRIATE GROUND WATER

RECEIVED
JAN 27 1950
STATE ENGINEER
SALEM, OREGON

TO THE STATE ENGINEER OF OREGON:

I, E. S. BELLOWS, Managing Director, HUNTINGTON RUBBER MILLS

of P. O. Box 570, Portland 7, Oregon (Mailing address) County of Multnomah

State of Oregon, do hereby make application for a certificate of registration as evidence of a right to appropriate ground water.

1. **Source** from which water is withdrawn is Pump Well (Flowing well, pump well, infiltration trench, or tunnel)

2. **Location** is: 7100 S. W. Macadam Avenue, Portland 1, Oregon (Approximate distance and direction from nearest city or town);

and is more particularly described as follows: 2500 feet west & 1150 feet south from NE Corner Section 22.

(a) ~~Site plan - 7100 SW Macadam Avenue, Portland, Oregon~~ (Give distance and bearing to corner of section or other legal subdivision)

being within NW¼ of NE¼ (Smallest legal subdivision) of Sec. 22, Twp. 1 S (N. or S.), Rge. 1 East (E. or W.)

or (b) within limits of recorded platted property, town or city: Portland, Oregon

in Lot ---, Block ---- of ---- (Name of plat or addition)

(If within city or town, give name) County of Multnomah

(Original well was drilled in 1918 or 1919)

3. **Construction Work** was begun on August, 1943 (Date); was completed on September, 1943 (Date)
(site of new well approx. 11½ ft. from old location)
and the ground water claimed was first used for the purposes set out below on September, 1943 (Date),

since which time the water has been used continuously (Continuously or intermittently)

from September, 1943 (Date) to Date - 7/2/58 (Date)

4. **Quantity** of water claimed and used is 150 gallons per minute; ----- acre feet per year.

5. **Purpose or Purposes** for which water is used Cooling mixing equipment and pressurizing on press line (Domestic, irrigation, municipal, manufacturing, industrial, etc.)

6. **Description of Well:** Depth 235 feet. Type Drilled (Dug or drilled)

diameter 10 inches. Elevation of ground at well site 42.92 (As near as known) feet, mean sea level.

Depth to water table 223 feet.

7. **Capacity of Well:** 150 g.p.m. with 80 feet drawdown.

g.p.m. with feet drawdown.

Date of test September, 1943

If Flowing Well: Measured discharge g.p.m. on (Date)

Shut-in pressure at ground surface lbs. per sq. in. on (Date)

Water is controlled by (Cap, valve, etc.)

8. **Casing:** (Give diameter, commercial specifications and depth below ground surface of each casing size.)

10" inch diameter from 2' above grd level to 230 feet

inch diameter from to feet

inch diameter from to feet

inch diameter from to feet

Describe and show depth of shoe, plug, adapter, liner or other details: ---------

9. **Perforated Casings or Screens:**

(Number per foot and size of perforations, or describe screen) from to

from to

from to

from to

10. **Log of Well:** (Describe each stratum or formation clearly, indicate if water bearing, and give thickness and depth as indicated.)

MATERIAL	Thickness (Feet)	Depth to Bottom (Feet)
Clay	0 to 17'	
Gravel - slight water flow 25' to 76'	17' to 54'	
Sand	54' to 57'	
Gravel	57' to 76'	
Rock with clay seams	76' to 223'	
Sand	223' to 224.5'	
Fractured Rock	224.5' to 235'	
Bottom		235'
Water Strata 223' to 235'		

GR 3937

If log of well is not available, give name and address of driller. .....

O. B. Olsen, Gresham, Oregon

11. **Infiltration Trench:** Covered or open .....

Dimensions: Length ..... ft. Minimum depth ..... ft. Maximum depth ..... ft.

Bottom width ..... ft. Discharge ..... g.p.m. Date of test .....

12. **Tunnel:** Type of lining .....

Dimensions: .....
(Length, course, and cross-sectional size)

Position of water bearing stratum with reference to portal of tunnel .....

Log of tunnel: (Preceding table for log of well may be used, if desired. Give footage from portal and character of materials, as pertinent.)

13. **Pumping Equipment:**

(a) Pump Deming Deep Well Pump 3' Discharge (Make, type and size) Capacity 150 g.p.m.

(b) Motor 10 HP - Size B Figure 1700 Serial T5187 (Type and horsepower)

14. Location of area irrigated or to be irrigated, or place of use if for purposes other than irrigation.

Township North or South	Range E. or W. of Willamette Meridian	Section	Forty-acre Tract	Number Acres To Be Irrigated	Date of Reclamation
1 S	1 East	22	~~Portland, Oregon - County of Multnomah, Oregon~~		
"	"	"		industrial uses	1943
			West 1/2 of NE 1/4		

15. If the ground water supply is supplemental to an existing water supply, identification of any application for a permit, permit, certificate or adjudicated right to appropriate water made or held by the registrant.

.....

.....

GR 3937

Township 1 S. Range 1 East, W.M.

North

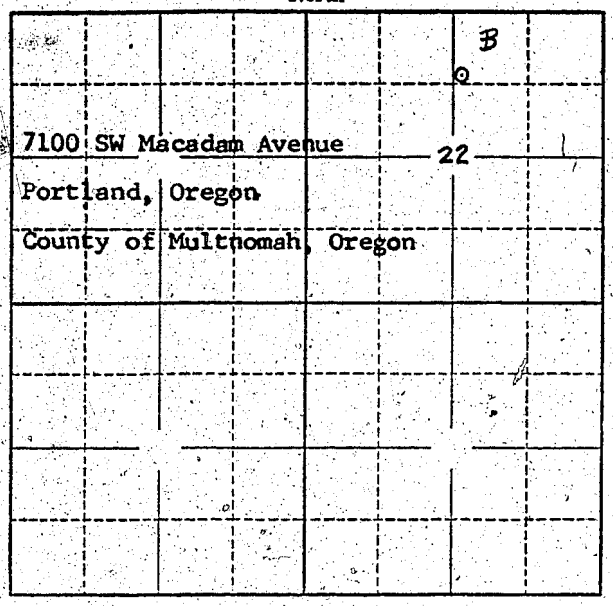

Locate well and acreage of irrigated land on plat.

Scale: 2" = 1 Mile

STATE OF OREGON
County of MULTNOMAH } ss.

I, E. S. BELLOWS, being first duly sworn, do hereby certify that I have read the foregoing Registration Statement and that all of the items therein contained are true to the best of my knowledge and belief.

E S Bellows
(Signature of Registrant)

Subscribed and sworn to before me this 3rd day of July, 1958

My commission expires NOTARY PUBLIC FOR STATE OF OREGON
MY COMMISSION EXPIRES MAY 8, 1961
(Notary Public)

(SEAL)

CERTIFICATE OF REGISTRATION

STATE OF OREGON
County of Marion } ss.

This is to certify that the foregoing Registration Statement was received in the office of the State Engineer on the 7th day of July, 1958, at [illegible] o'clock [illegible] M. and has been duly recorded in said office in Book No. 16 of Registration Statements on page GR-3937

Witness my hand this 15th day of February, 1960

Lewis A. Stanley
(State Engineer)

$20.00

By
(Deputy)

GR 3937